


Ellis

KANSAS

SECTION # 4 TOWNSHIP 12 RANGE 20W

WELL NO. #3 Hamburg

COMPANY I.O. Miller

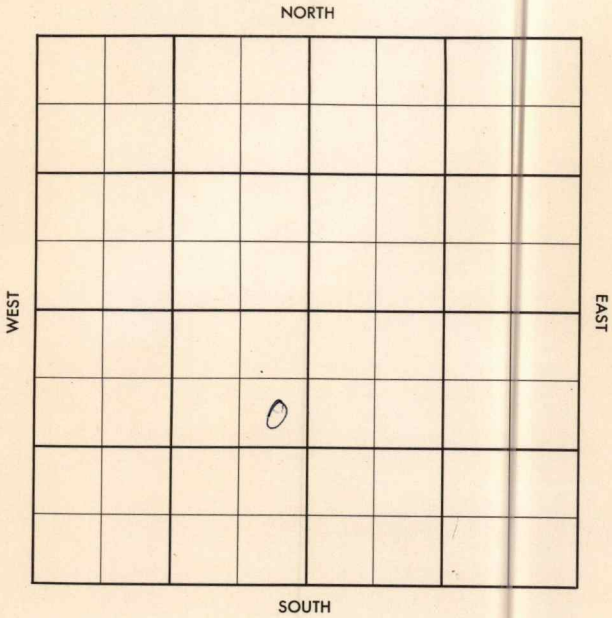

County Ellis Elev. 2270
 Sec. 4 Twp. 12 Rge. 20W
 Company I. O. Miller
 Farm Name Hamburg No. 3

TOPS	DEPTH	LOG	DATUM	Loc in Sec.
Anh.				SE NE SW
Tp.	3335			
H.	3561			
Tr.	3583			
Dg.				
Bl.				
L.	3599			Geo Pat Simmons
K.C.				Conte
B.K.C.	3817			Virginia Tools
Ce.				
C. <u>NACH CRT</u>	3893			
M. <u>CG</u>	3931			
M.				Pool
K.				
Mz.				
Me.				
V.				
S.				
S.				
A.	3996			
R.				
PE.				
G.				
T.D.	4045			

ABANDONED

JAN 9 '57

Date Comm. 12-16-56

8" @ 263 w/125, WOC DEC 26 '56 JAN 2 '57

JAN 9 '57

DST 375.5 - 97 ga 45"

res 30' Md BHP 225/15"

D&A (156/15)

County Ellis

Elev. _____

Sec. 4Twp. 12Rge. 20WCompany I. O. MillerFarm Name HamburgNo. 3

TOPS

DEPTH

LOG

DATUM

Loc. in Sec. _____

Anh. _____

Tp. _____

H. _____

Tr. _____

Dg. _____

Bl. _____

L. _____

K.C. _____

B.K.C. _____

Ce. _____

C. _____

M. _____

M. _____

K. _____

Mz. _____

Mq. _____

V. _____

S. _____

S. _____

A. _____

R. _____

P.E. _____

G. _____

T.D. _____

SE NE SW

Geo Pat Simmons

Contr. _____

Virginia Tools

Pool

DEC 19 1956

FIRST REPORT

Date Comm. 12-16-56

8" @ 263 w/125, WOC

Co.

Lse.

No.

Sec.

T.

R.