


Section 7 Township 12 Range 20 W

Well No. # 1 Skaggs

Company Herndon Drlg.

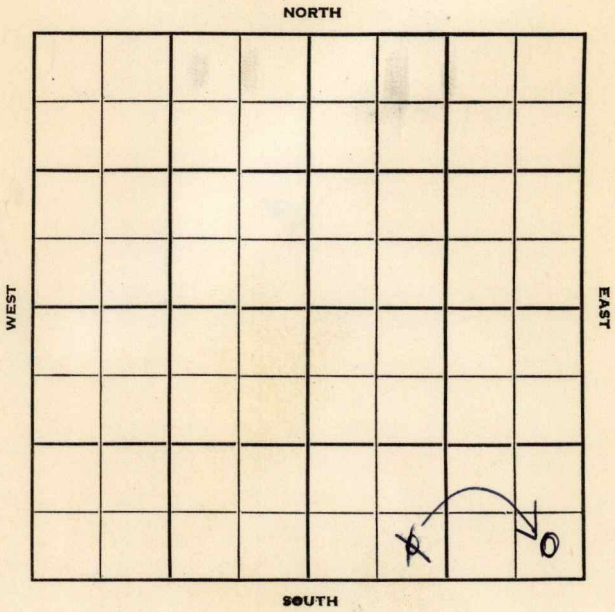

Sec. 7 Twp. 12 R. 20W

Well No. #1 Skaggs Farm _____

Herndon Drlg. Company _____

Contractor _____

Wildcat

330 Ft. from N. Line


330 Ft. from S. Line

330 Ft. from E. Line

~~990~~ Ft. from W. Line

~~SE SE SE~~

~~SE SW SE~~

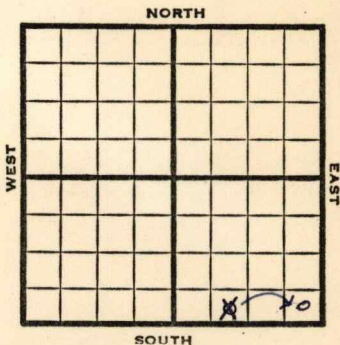

1951

Elev. 2303' REPORT

10/31

Spud 10-28-51
8" @ 280' WOC

11/14

Spud 10-28-51
 D & A TD 4058' 8" @ 280'
Heeb 3590' Lans. 3630'
 DST 3827-39' open 1/2 hr. rec 5' SGCM
B KC 3891' Cong. 3908'
 DST 3941-55 open 1 hr. rec 4' oil
 14' mud
Arb. 4008' TD 4058' D & A

ABANDONED

Kansas

Map No. _____ Sec. 7 Twp. 12 R. 20W

Well No. 1 Skaggs

Herndon Drlg. Company

CORRECTION

Contractor

SE SE SE

SECTION PLAT

_____ Ft. from N. Line

330 Ft. from S. Line

330 Ft. from E. Line

_____ Ft. from W. Line

			0

Ellis County

Location _____

Rig up _____

Drilling and Remarks:

Reported
SE SW SE

RECORD

Cased _____ in., _____ ft.

Sand _____

Gas _____

Oil _____

Total Depth _____

PRODUCTION

1st 24 hrs. Nat. _____

1st 24 hrs. after shot _____

Gas _____ Cu. Ft.

Dry Hole _____

Abandoned _____

Date

NOV 7 1951 19

J. E. TYRA Scout

