

KANSAS


FORM 51 5M 1-42 PETROL

Woodson

Section 64 Township 24 Range 14-E

Well No. ¹¹ #1 Wintersheid

Company Kornfeld & Harper

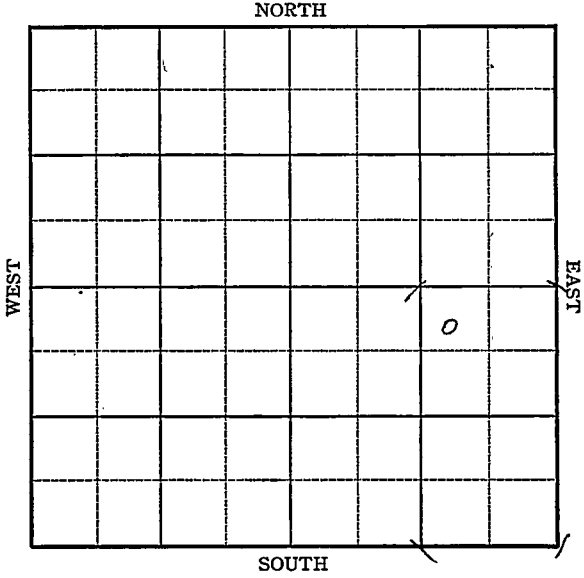

KANSAS


Woodson

Sec. 6 Twp. 24 R. 14-E

Well No. #1 Winterschied Farm

Kornfeld & Harper Company

400 Ft. from N. Line
 _____ Ft. from S. Line
990
~~330~~ Ft. from E. Line
 _____ Ft. from W. Line
 Miscellaneous

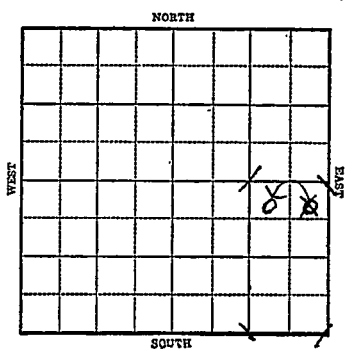

1943

R E P O R T

7/28 Drlg. 175
 8/4 12" @ 12'
 Drlg. 350'
 8/11 Drlg. 815'
 10" @ 820'
 8/18 1165 run 8"
 8/25 8" @ 1165 -
 1275 SD
 9/1 1410 SD
 9/8 Drlg. 1628
 9/15 Miss 1718
 T.D. 1760'
ABANDONED

KANSAS

Map No. 17 Sec. 6 Twp. 24 R. 14E

Well No. 1 Winterscheid

Kornfeld & Harper Company
FIRST REPORT

Contractor

NE SE

SECTION PLAT

400 Ft. from N. Line

_____ Ft. from S. Line

330 Ft. from E. Line

_____ Ft. from W. Line

MISCELLANEOUS

Location _____

Rig up _____

Drilling and Remarks:

Drlg. 175

RECORD

Cased _____ in., _____ ft.

Sand _____

Gas _____

Oil _____

Total Depth _____

PRODUCTION

1st 24 hrs. Nat. _____

1st 24 hrs. after shot _____

Gas _____ Cu. Ft.

Dry Hole _____

Abandoned _____

Date

JUL 28 1943 19

S. J. LEWIS Scout

KANSAS

Map No. 17 Sec. 6 Twp. 24 R. 14E

Well No. 1 Winterscheid

Kornfeld & Harper Company

ABANDONED

Contractor

NW NE SE

SECTION PLAT

400 Ft. from N. Line

_____ Ft. from S. Line

990 Ft. from E. Line

_____ Ft. from W. Line

			o
	.		

Miscellaneous

Location _____

Rig up _____

Drilling and Remarks:

Miss 1715

RECORD

Cased _____ in., _____ ft.

Sand _____

Gas _____

Oil _____

Total Depth 1760

PRODUCTION

1st 24 hrs. Nat. _____

1st 24 hrs. after shot _____

Gas _____ Cu. Ft.

Dry Hole _____

Abandoned _____

Date

SEP 15 1943

19

S. J. LEWIS

Scout