


Section 10 Township 12 Range 20-W

Well No. #1 Ergert

Company Texas Co.

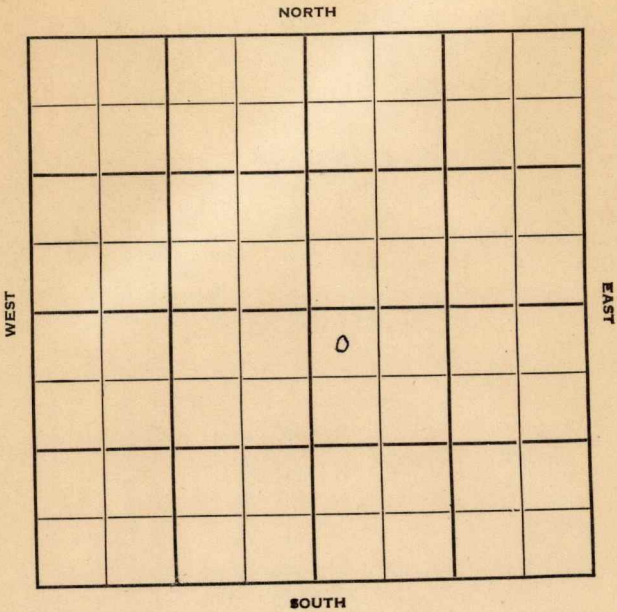

Sec. 10 Twp. 12 R. 20-W

Well No. #1 Erbert Farm

Texas Co Company

Anschutz Drlg. Contractor

Sweet William


330 Ft. from N. Line

_____ Ft. from S. Line

_____ Ft. from E. Line

330 Ft. from W. Line

NW NW SE

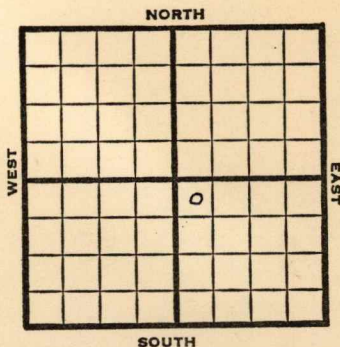

1950

Elev. 2194' REPORT

10/18 Spud 10-16-50
drlg 1598

11/22 Spud 10-16-50
D&A TD 3930'
10-3/4" @ 1593' Top 3252'
Heeb. 3480' Lans. 3521'
Cong. 3841' Arb. 3878'
7" @ 3880' TD 3896'
S/1 goph 500 A
B/51 go 61 gal acid wtr DD 3930
No inc. SP 3760 4/3728-32
4/3718-22 32/3718-32 1500 A
S/15 bfph SSO SP 3711
12/3706-09 16/3709-10 FU 2300'
fluid, mostly wtr SSO PB 3688
24/3678-84 B/2 gfph 50% oil
1000 A S/20 goph 3000 A
S/1 boph for 6 hr SP 3670
24/3655-61 S/11 go 1/2 hr
1000 A S/1 1/4 boph 3000 A
S/4 boph S/1 1/4 boph SP 3544
24/3523-29 2000 A S/18 gwph
no oil Sq. off 3523-29
CO to 3696 S/20 bo 13 hr
B/27 go 23 gw 1 hr TD 3930
S/3 1/2 go 4 gwph
D&A **ABANDONED**

Drlg. Data

CO to 3696 S/ 20 bo 13 hr. B/ 27 go

23 gw 1 hr. TD 3930 S/ $3\frac{1}{2}$ go 4 gwph

D & A

NOV 30 1950

Soart Cards
Land Small Map
Land Wall Map
Tracings
France Map
Pierce Map
MISC.