

Woodson


Form 51-5M-2-29-34703

Map No. KANSAS Sec. 6 Twp. 24 R. 14

Well No. 1 - Wintersfield Farm

Gates Oil Company

NORTH

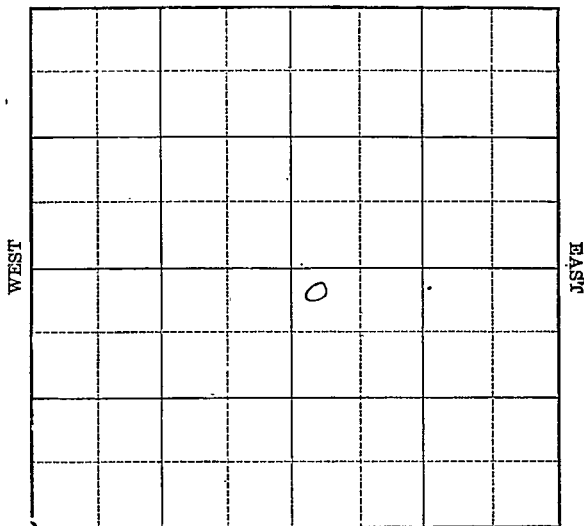

SOUTH

Location \_\_\_\_\_

Drilling Remarks \_\_\_\_\_

\_\_\_\_\_

\_\_\_\_\_

Rig Up \_\_\_\_\_

Drilling Remarks \_\_\_\_\_

\_\_\_\_\_

\_\_\_\_\_

RECORD

Cased \_\_\_\_\_ in. \_\_\_\_\_ ft.

Sand \_\_\_\_\_

Gas \_\_\_\_\_

Oil \_\_\_\_\_

Total Depth \_\_\_\_\_

PRODUCTION

1st 24 hrs. Nat. \_\_\_\_\_

1st 24 hrs. after shot \_\_\_\_\_

Gas \_\_\_\_\_ cu. ft. \_\_\_\_\_

Dry Hole \_\_\_\_\_

Abandoned \_\_\_\_\_

*Woodson*

MAP No. *Kwy* SEC. *6* TWP. *24* R. *14*

WELL No. *1 Wintershied*  
*Gates Oil Co* COMPANY

**FIRST REPORTS  
 COMPLETED**

CONTRACTOR  
**SECTION PLAT**

\_\_\_\_\_ FT. FROM N. LINE  
 \_\_\_\_\_ FT. FROM S. LINE  
 \_\_\_\_\_ FT. FROM E. LINE  
 \_\_\_\_\_ FT. FROM W. LINE

		<i>0</i>	

LOCATION \_\_\_\_\_

RIG UP \_\_\_\_\_

DRILLING AND REMARKS:  
*20 Bls.*

**RECORD**

CASED \_\_\_\_\_ IN. \_\_\_\_\_ FT.  
 SAND *1721-29*  
 GAS \_\_\_\_\_  
 OIL \_\_\_\_\_  
 TOTAL DEPTH *1729*

**PRODUCTION**

1ST 24 HRS. NAT. \_\_\_\_\_  
 1ST 24 HRS. AFTER SHOT \_\_\_\_\_  
 GAS \_\_\_\_\_ CU. FT.  
 DRY HOLE \_\_\_\_\_  
 ABANDONED \_\_\_\_\_

DATE \_\_\_\_\_

*Alexwood* SCOUT