


DX 78-1 Ellis

KANSAS

Section 18 Township 12 Range 20W

Well No. #1 Schwab

Company H. Kaiser & Francis Oil & Gas

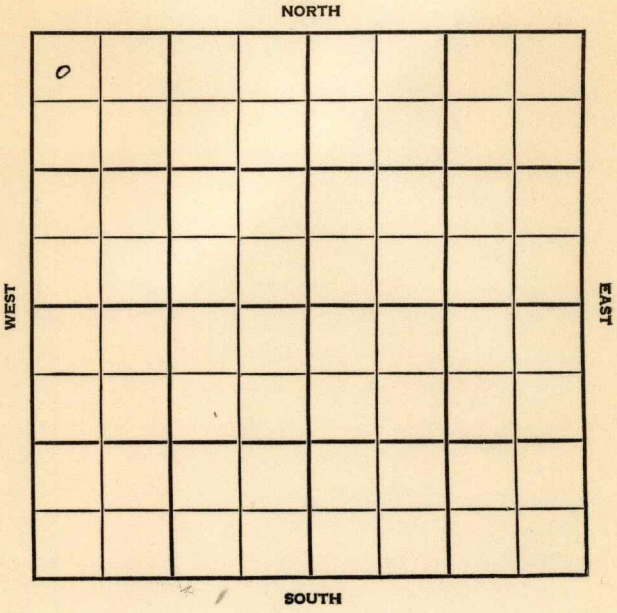

Ellis KANSAS

SEC.	TWP.	R.
18	12	20W


WELL NO. **1 Schwab** FARM

COMPANY **H. Kaiser & Francis O&G**

CONTRACTOR **K & E Drlg.**

"wildcat

330 Ft. from N. Line
 _____ Ft. from S. Line
 _____ Ft. from E. Line
330 Ft. from W. Line

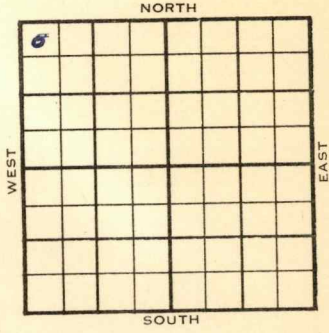

NW NW NW
CSO - FO - Stanolind-DHM

1954	ELEVATION 2302'	REPORT
------	---------------------------	--------

11/17 Spud 11-11-54
 8" @ 247'
Anhy 1690'
 Drlg. 3083'

11/23 Spud 11-11-54 D & A TD 4058
 8" @ 247 **Anhy 1690'** Heeb 3610
 Tor. 3628 Lans 3646 B KC 3890
 Marm. 3942 Cong. 3994 Arb. 4035
 TD 4058' D & A

ABANDONED

County **Ellis** State **Kansas**

Sec. **18** (Blk. Twp.) **12** (Sur. Rge.) **20W** Map No.

Operator **H. Kaiser & Francis Oil & Gas**

Well No. **1** Farm **Schwab**

Elev. **2302** Location **NW NW NW**

o					
FIRST REPORT					

330 Ft. From **N** Line **NW**

330 Ft. From **W** Line **Quarter**

1st. Report **NOV 17 1954**

Completion

Remarks **CSO - FO Stanolind - DHM**

K & E Drlg. - Contr.

Spudding Date **11-11-54**

Drlg. Data **Wildcat**

8" @ 247 Anhy 1690 drlg. 3083

FABEN GILSTRAP

County Ellis State Kansas

Sec. 18 (Blk.) 12 (Sur.) 20W Map No.

Operator H. Kaiser & Francis Oil & Gas

Well No. 1 Farm Schwab

Elev. 2302 Location NW NW NW

0					

330 Ft. From N Line NW

330 Ft. From W Line Quarter

Ist. Report

Completion NOV 23 1954

Remarks Wildcat

K & E Drlg. - Contr.

Spudding Date 11-11-54

Drlg. Data D & A TD 4058

8" @ 247 Anhy 1690 Heeb. 3610

Tor. 3628 Lans. 3646 B KC 3890

Marm. 3942 Cong. 3994 Arb. 4035

TD 4058

D & A