


SECTION 17 TOWNSHIP \_\_\_\_\_ RANGE 12S 20W

WELL NO. #1 Reitmeyer

COMPANY Nadel & Gussman

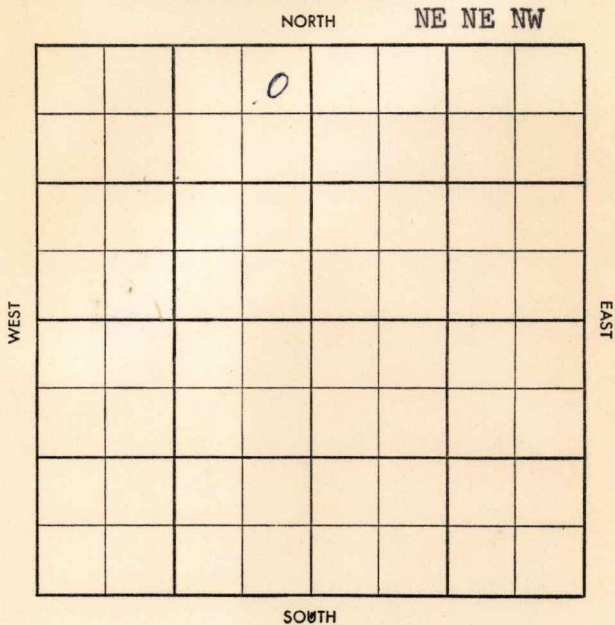



S-513-B

~~Twp~~ ~~Pool~~  
~~Co~~ ~~Foot~~

County Ellis Elev. 3281 or 2284  
 Sec. 17 Twp. 12 Rge. 20W  
 Company Nadel & Gussman  
 Farm Name Reitmeyer No. 1

TOPS	DEPTH	LOG	DATUM	Loc. in Sec.
Anh.	<u>1655</u>			<u>NE NE NW</u>
Tp.				
H.	<u>3560</u>			
Tr.	<u>3581</u>			
Dg.				
B.L.				
L.	<u>3597</u>			
K.C. <u>mor</u>	<u>3898</u>			Geol.
B.K.C.				Contr.
Ce.				
C. <u>cherty</u>	<u>3931</u>			<u>Reserve #3</u>
M.				Pool
M.				<u>Wildcat</u>
K.				
Mz.				
Mq.				
V.				
S.				
S.				
A.	<u>3971</u>			
R.				
Pf.				
G.				
T.D.	<u>4000</u>			<u>JUL 23 '58</u>

Date Comm. 7-8-58 8"201/135  
 Rurt JUL 16 '58 TTD 2970 JUL 23 '58 DST 3971  
-80 1hr 10' M NS BHPD  
log

DA

Co.  
Lse.  
No.  
Sec.  
T.  
R.