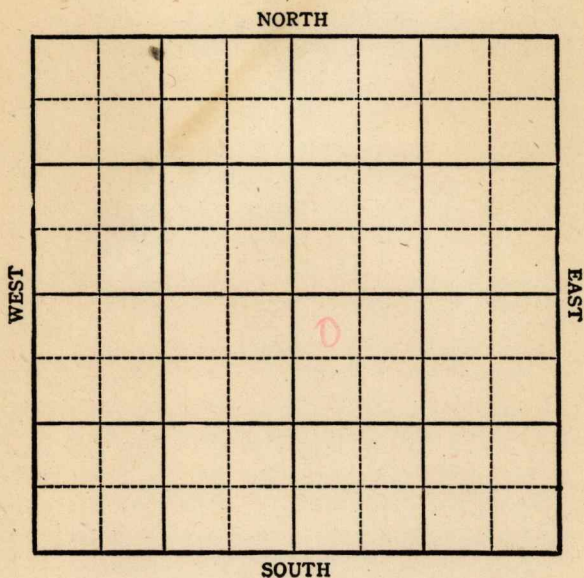


KANSAS

Ellis

Section 19 Township 12 Range 20WWell No. #1 Huber "C"Company Sunray Oil

KANSAS

Ellis

Sec. 19 Twp. 12 R. 20W

Well No. 1 Huber "C" Farm

Sunray Oil

Company

Wildcat


330 Ft. from N. Line

Ft. from S. Line

Ft. from E. Line

330 Ft. from W. Line

NWSE

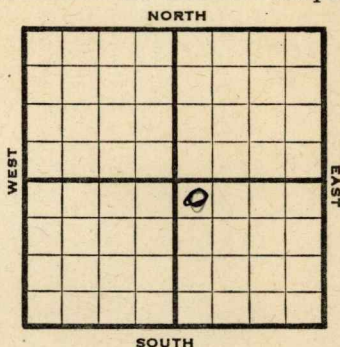

1944

R E P O R T

11/22 R U R
11/29 10" @ 187 Drlg 3035


12/6 Lans 3559
BKD. 3804
Cong 3912
Arb. 3958
TD 3969'
Water

ABANDONED

Pool Name WildcatMap No. 70 Sec. 19 Twp. 12 R. 20WWell No. 1 Huber "C"Sunray Oil CompanyFIRST REPORT Contractor

NW SE

SECTION PLAT

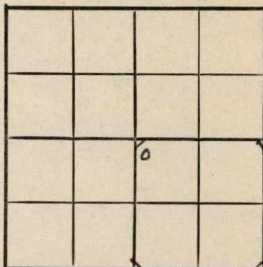330 Ft. from N. Line Ft. from S. Line Ft. from E. Line330 Ft. from W. LineEllisLocation Rig up

Drilling and Remarks:

R U R

RECORD

Cased in., ft.Sand Gas Oil Total Depth

PRODUCTION

1st 24 hrs. Nat. 1st 24 hrs. after shot Gas Cu. Ft.Dry Hole Abandoned

Date

NOV 22 1944

19

S. J. LEWIS

Scout

Pool Name WildcatMap No. 70 Sec. 19 Twp. 12 R. 20WWell No. Huber "C"Sunray Oil CompanyABANDONED Contractor

NW SE

SECTION PLAT

330 Ft. from N. Line Ft. from S. Line Ft. from E. Line330 Ft. from W. Line

		0	

EllisLocation Rig up

Drilling and Remarks:

Line 3558BKC3804Comp 3912Art 3958Water

RECORD

Cased in., ft.Sand Gas Oil Total Depth 3969

PRODUCTION

1st 24 hrs. Nat. 1st 24 hrs. after shot Gas Cu. Ft.Dry Hole Abandoned

Date

DEC 6 1944

19

S. J. LEWIS

Scout