

KANSAS


FORM 51 5M 1-42 PETROL

Ellis

Section 19 Township 12 Range 20W

Well No. #1 Reich

Company Tom Palmer

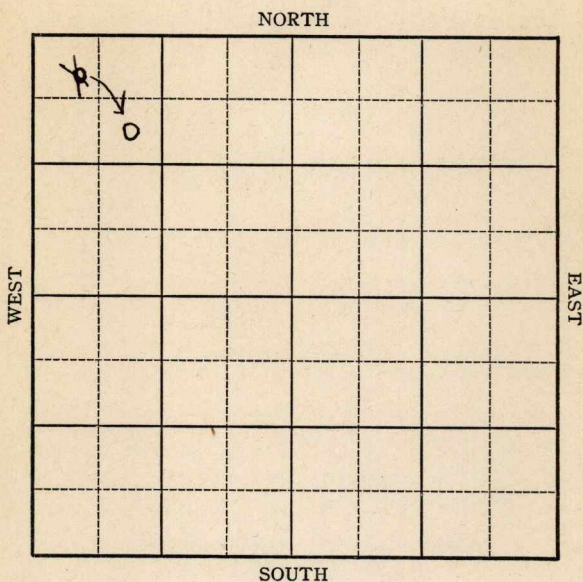

KANSAS

Sec. 19 Twp. 12 R. 20W

Well No. #1 Reich Farm

Tom Palmer

Company

(Wildcat)


990 Ft. from N. Line

_____ Ft. from S. Line

_____ Ft. from E. Line

990 Ft. from W. Line

E 2294 LS

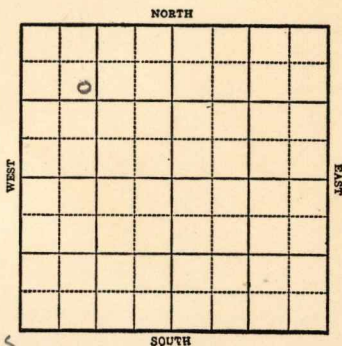

1942

R E P O R T

11/4 surface hole
11/11 8" @ 135'
Anhy 1685
Drlg. 2545'
11/18 Drlg. 3325
Topeka 3220
11/24 Topeka 3330
Lans 3588
BKC 3836
Arb. 3986
T.D. 3998'
Show dead oil

ABANDONED

KANSAS

Ellis

Map No. 70 Sec. 19 Twp. 12 R. 20WWell No. 1 Reich

Tom Palmer

Company

FIRST REPORT

Contractor

SE NW NW


990 Ft. from N. Line

Ft. from S. Line

Ft. from E. Line

990 Ft. from W. Line

SECTION PLAT

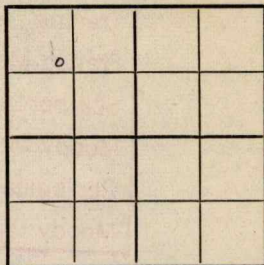

WILDCAT

Location

Rig up

Drilling and Remarks:

Surface Hole

RECORD

Cased _____ in., _____ ft.

Sand _____

Gas _____

Oil _____

Total Depth _____

PRODUCTION

1st 24 hrs. Nat. _____

1st 24 hrs. after shot _____

Gas _____ Cu. Ft.

Dry Hole _____

Abandoned _____

Date

NOV 4 1942 19 S. J. LEWIS Scout

KANSAS

Ellis

Map No. 70 Sec. 19 Twp. 12 R. 20WWell No. 1 Reich

Tom Palmer

Company

ABANDONED

Contractor

SE NW NW

SECTION PLAT

990 Ft. from N. Line Ft. from S. Line Ft. from E. Line990 Ft. from W. Line

WILDCAT

Location Rig up

Drilling and Remarks:

Topoka 330
lane 3088
BTC 3806
Cr 43976
Show Dead oil

RECORD

Cased in., ft.Sand Gas Oil Total Depth 3998

PRODUCTION

1st 24 hrs. Nat. 1st 24 hrs. after shot Gas Cu. Ft.Dry Hole Abandoned

Date

NOV 24 1942

19

S. J. LEWIS

Scout