



*Woodson*

Map No. KANSAS Sec. 6 Twp. 24 R. 14<sup>E</sup>

Well No. 3 Wintersheid Farm


Okla Oil Company

640' Ft. from N. Line

\_\_\_\_\_ Ft. from S. Line

\_\_\_\_\_ Ft. from E. Line

714' Ft. from W. Line

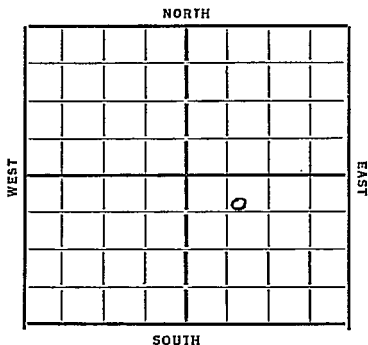

Date 12/22

REPORT

11/28 L.O. log 750'

12/6 T.D. 1245 - run 12"

12/13 Top Line 1676 - 6" 1678 T.D. 1721 - 125' oil  
12 - hrs 1000 gal acid

12/20 Top Line 1676 - T.D. 1721  
57 bbls oil & 2 bbls water

COMPLETED

Map No. 17 Sec. 6 Twp. 24 R. 14E

Well No. 3-Wintersheid

Oil Company

Contractor

**FIRST REPORTS**

640 Ft. from N. Line

..... Ft. from S. Line

..... Ft. from E. Line

714 Ft. from W. Line

**SECTION PLAT**

		○	

Location.....

Rig up.....

Drilling and Remarks:

Key 750

**RECORD**

Cased..... in., ..... ft.

Sand.....

Gas.....

Oil.....

Total Depth.....

**PRODUCTION**

1st 24 hrs. Nat.....

1st 24 hrs. after shot.....

Gas..... Cu. Ft.

Dry Hole.....

Abandoned.....

Date

11-28-33 192 O. Munnick Scout

Map No. 17 Sec. 6 Twp. 24 R. 14 E

Well No. 3 - Winterscheid

Obs Oil

Company

Contractor

~~COMPLETED~~

SECTION PLAT

640 Ft. from N. Line

		0	

..... Ft. from S. Line

..... Ft. from E. Line

714 Ft. from W. Line

Location.....

Rig up.....

Drilling and Remarks:

57 oil  
2 water

RECORD

Cased..... in., ..... ft.

Sand top lime 1676

Gas.....

Oil.....

Total Depth 1721

PRODUCTION

1st 24 hrs. Nat.....

1st 24 hrs. after shot.....

Gas..... Cu. Ft.

Dry Hole.....

Abandoned.....

Date

12-20-33 O. Wannerbrook Scout