


DX 78-1 Ellis

KANSAS

Section 21 Township 12 Range 20W

Well No. #1 Nicholson

Company Jones, Shelburne & Farmer

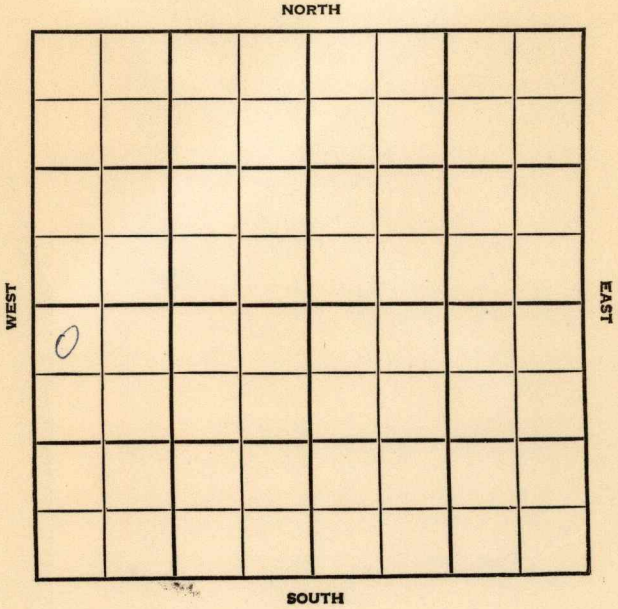

County Ellis Elev. 2212
 Sec. 21 Twp. 12 Rge. 20W
 Company Jones, Shelburne & Farmer
 FarmName Nicholson No. 1

Co.

	TOPS	DEPTH	LOG	DATUM	Loc. in Sec.						
Anh.		1575			NW NW SW						
Tr.											
Dg.											
BL.					Geol.						
L.		3515	3515								
K.C.					Contr.						
B.K.C.			3758								
Ce.					Co. tools						
C.		3854	3856								
M.					Pool						
M.											
K.					Semi-Wildcat						
Mz.											
Me.					<table border="1"> <tr> <td colspan="2">ABANDONED</td> </tr> <tr> <td>0</td> <td></td> </tr> <tr> <td>SEP</td> <td>5 '56</td> </tr> </table>	ABANDONED		0		SEP	5 '56
ABANDONED											
0											
SEP	5 '56										
V.											
S.											
S.											
A.		3879	3877								
R.											
Pe.											
G.											
G.											
TD.		3885									

Lse.

No.

Sec.

T.

R.

SE

Date Comm. 8-8-56
8" @ 162/115 drlg. 2895 AUG 22 '56
DST 3535-60 90" rec 215'
WC & SGCM BHP 1010/30" DST
3574-3600 90" rec 120' SGCM
BHP 1250/20 DST 3685-3710
1hr rec 25' Md BHP 60/30
DST 3708-30 30" rec 20' Md
1340/ DST 3814-30 rec 1hr
rec 120' oil + 120' HMCO + 120' SEP 5 '56

HOCM BHP 540/32 5 1/2
@ 3881 AUG 29 '56 SEP 5 '56 DD 3924
show wtr PB 38.34 48/3815-21
fst 1/2 Boph no/w 1/2 no inc.
Frac 2 x 3 Lost Load

D&A

County Ellis Elev. _____
 Sec. 21 Twp. 12 Rgs. 20W
 Company Jones, Shelburne & Farmer
 Farm Name Nicholson No. 1

TOPS	DEPTH	LOG	DATUM
Anh.	1575		
Tp.			
H.			
Tr.			
Dg.			
Bl.			
L.			
K.C.			
B.K.C.			
Ce.			
C.			
M.			
M.			
K.			
Mz.			
Me.			
V.			
S.			
S.			
A.			
R.			
Pe.			
G.			
T.D.			

Loc. in Sec. _____
NW NW SW
 Geol. _____
 Contr. _____
Co. tools
 Pool ELLIS
Semi-Wildcat

FIRST REPORT

Date Comm. 8-8-56 AUG 15 '56
8" @ 162/115 drlg. 2895

AUG 5 1956

R.G.R.

(Handwritten signature)

Co.
Lse.
No.
Sec.
T.
R.