

KANSAS


FORM 51 5M 1-42 PETROL

Ellis

Section 23 Township 12 Range 20-W

Well No. #1 Caschler

Company Phillips

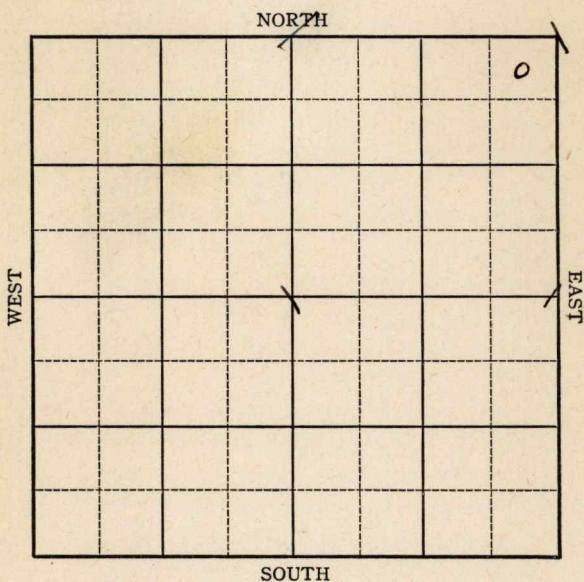

KANSAS

Ellis

Sec. 23 Twp. 12 R. 20-W

Well No. #1 Gaschler Farm

Phillips Company

Wildcat


330 Ft. from N. Line

 Ft. from S. Line

330 Ft. from E. Line

 Ft. from W. Line

Elv. 2232

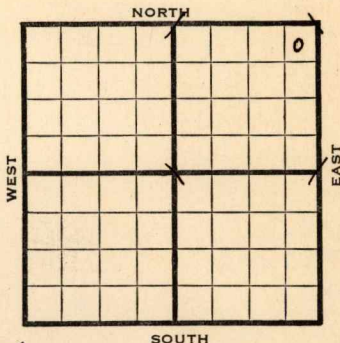

1943

REPORT

8/4 Location.

8/11 Rotary

3/18 8" @ 1419'
Drlg. 1841'

8/25 Topeka 3274
SSO 3309-11
Lans 3536
Drlg. 3560'

9/1 Cong 3824
Arb 3935
T.D. 3965'

ABANDONED

Ellis

Map No. **KANSAS** Sec. 23 Twp. 12 R. 20WWell No. 1 Gaschler

Phillips


Company

FIRST REPORT

Contractor

NE/C

SECTION PLAT

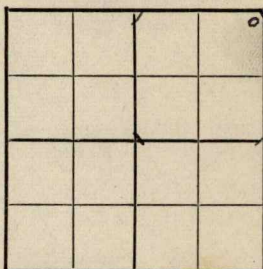330 Ft. from N. Line Ft. from S. Line330 Ft. from E. Line Ft. from W. Line

WILDCAT

Location XXXRig up

Drilling and Remarks:

RECORD

Cased in., ft.Sand Gas Oil Total Depth

PRODUCTION

1st 24 hrs. Nat. 1st 24 hrs. after shot Gas Cu. Ft.Dry Hole Abandoned

Date

AUG 4 1943 19S. J. LEWIS Scout

KANSAS

Map No. 70 Sec. 23 Twp. 12 R. 20WWell No. 1 GaschlerPhillips


Company

ABANDONED

Contractor

NE/C

SECTION PLAT

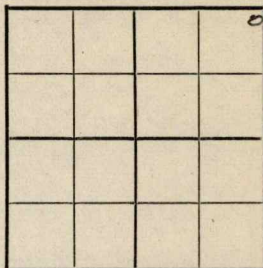330 Ft. from N. Line

Ft. from S. Line

330 Ft. from E. Line

Ft. from W. Line

Wildcat

Location

Rig up

Drilling and Remarks:

Cong 3824
CR + 3225

RECORD

Cased _____ in., _____ ft.

Sand _____

Gas _____

Oil _____

Total Depth 3965

PRODUCTION

1st 24 hrs. Nat. _____

1st 24 hrs. after shot _____

Gas _____ Cu. Ft.

Dry Hole _____

Abandoned _____

Date

SEP 1 1943 19S. J. LEWIS Scout