


Section 26 Township 12 Range 20N

Well No. #1 Kroeger

Company W. L. Hartman

NORTH

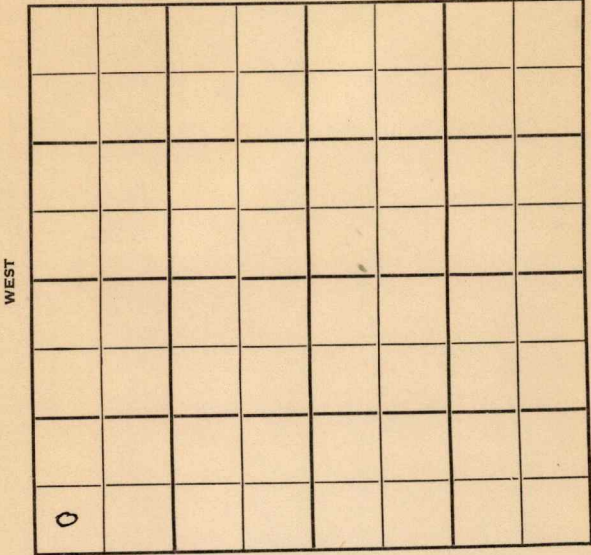

SOUTH

WEST

EAST

Sec. 26 Twp. 12 R. 20W

Well No. #1 Kroeger Farm

W. L. Hartman Company

Hartman Contractor

Wildcat


_____ Ft. from N. Line

330' Ft. from S. Line

_____ Ft. from E. Line

330' Ft. from W. Line

SW/C

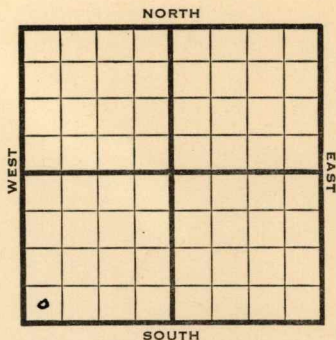

1949

Elev 2199' REPORT

11/2

Location

11/9

8" @ 120'

Drlg. 2145'

11/23

TD 3925'

Arb. 3899'

Aband.

ABANDONED

Map No. _____ Sec. 26 Twp. 12 R. 20W

Well No. 1 Kroeger

W. L. Hartman _____ Company

Hartman _____ Contractor

SW/C

FIRST REPORT
SECTION PLAT

_____ Ft. from N. Line

330 Ft. from S. Line

_____ Ft. from E. Line

330 Ft. from W. Line

Ellis County

Location _____ X

Rig up _____

Drilling and Remarks:

RECORD

Cased _____ in., _____ ft.

Sand _____

Gas _____

Oil _____

Total Depth _____

PRODUCTION

1st 24 hrs. Nat. _____

1st 24 hrs. after shot _____

Gas _____ Cu. Ft.

Dry Hole _____

Abandoned _____

Date

NOV 2 1949 19

S. J. LEWIS Scout

Kansas

Map No. _____ Sec. 26 Twp. 12 R. 2 OW

Well No. 1 Kroeger

W. L. Hartman Company

ABANDONED

Contractor

SW/C

E. 2199
SECTION PLAT

_____ Ft. from N. Line

330 Ft. from S. Line

_____ Ft. from E. Line

330 Ft. from W. Line

Ellis County

Location _____

Rig up _____

Drilling and Remarks:

Case 3899

RECORD

Cased _____ in., _____ ft.

Sand _____

Gas _____

Oil _____

Total Depth 8925

PRODUCTION

1st 24 hrs. Nat. _____

1st 24 hrs. after shot _____

Gas _____ Cu. Ft.

Dry Hole _____

Abandoned _____

Date

NOV 23 1949

19

S. J. LEWIS

Scout