

Woodson


Form 51-5M-2-29-34703

Map No. **KANSAS** Sec. 6 Twp. 24 R. 14

Well No. 5 - Winter shield Farm

Ocala P & R Company

NORTH

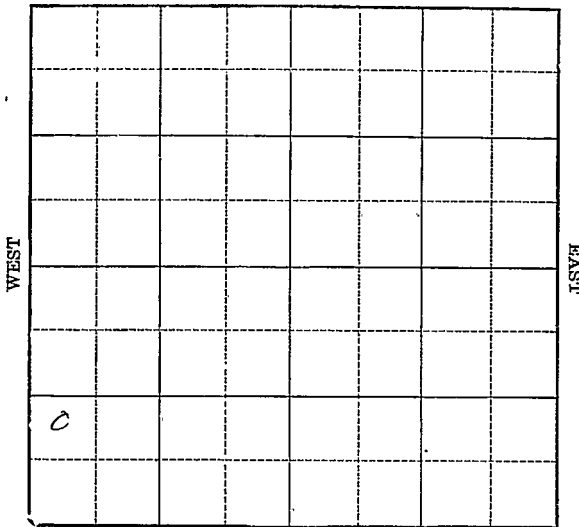

SOUTH

Location _____

Drilling Remarks _____

Rig Up _____

Drilling Remarks _____

RECORD

Cased _____ in. _____ ft.

Sand _____

Gas _____

Oil _____

Total Depth _____

PRODUCTION

1st 24 hrs. Nat. _____

1st 24 hrs. after shot _____

Gas _____ cu. ft.

Dry Hole _____

Abandoned _____

Woodson

MAP NO. *Kns* SEC. *6* TWP. *24* R. *14*

WELL NO. *5 Winterscheid*

Oklar PRR Co COMPANY

CONTRACTOR

**FIRST REPORTS
COMPLETED**

SECTION PLAT

<i>o</i>			

_____ FT. FROM N. LINE

_____ FT. FROM S. LINE

_____ FT. FROM E. LINE

_____ FT. FROM W. LINE

LOCATION _____

RIG UP _____

DRILLING AND REMARKS:

75 Blg.

RECORD

CASED _____ IN. _____ FT.

SAND _____ *-1717*

GAS _____

OIL _____

TOTAL DEPTH *1717*

PRODUCTION

1ST 24 HRS. NAT. _____

1ST 24 HRS. AFTER SHOT _____

GAS _____ CU. FT.

DRY HOLE _____

ABANDONED _____

DATE

6/25/20 192

Sherwood SCOUT