


Section 28 Township 12 Range 20W

Well No. #1 Erbert

Company Petroleum, Inc.

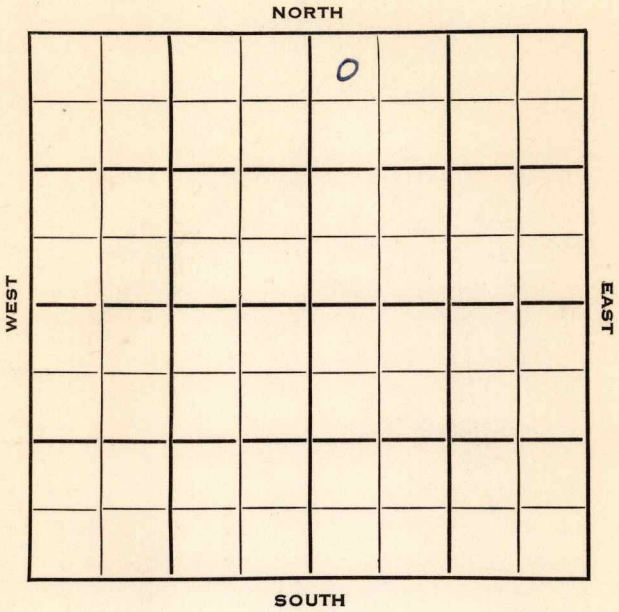

Sec. 28 Twp. 12 R. 20W

Well No. #1 Erbert Farm

Petroleum Inc. Company

Petroleum Inc. Contractor

Wildcat


330 Ft. from N. Line

_____ Ft. from S. Line

_____ Ft. from E. Line

330 Ft. from W. Line

NW NW NE

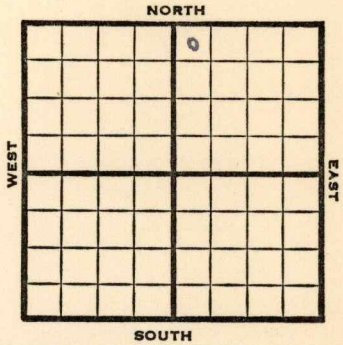

1953 **Elev. 2218'** REPORT

5/6 8" @ 205'
WOC

5/20 Spud 5-4-53 D & A TD 3940
 8" @ 205 Heeb 3476 Tor. 3497
Lans. 3513
 DST 3516-55 open 1 hr rec 10' SOCM
 Off
 DST 3569-3605 open 1 hr. rec 90' mud
 1200#
 DST 3605-50 open 1 hr rec 40' mud
 1150#
 DST 3703-17 open 1 hr rec 20' OCM,
 60' SOCM 875#
 DST 3717-40 open 1 hr rec 30' mud 665#
 DST 3798-3825 open 1 hr rec 33' SOCM
 265# **Cong. 3851 Arb. 3866'**
 DST 3867-70 open 3/4 hr. rec 18' mud
 Off
 DST 3869-75 open 3/4 hr. rec 8' mud Off
 DST 3875-83 open 3/4 hr. rec 8' mud
 TD 3940' D & A

ABANDONED

County **Ellis** State **Kansas**

Sec. **28** (Blk. **12**) (Sur. **20W**) (Twp.) (Rge.) Map No.

Operator **Petroleum Inc.**

Well No. **1** Farm **Erbert**

Elev. Location **NW NW NE**

			0		

330 Ft. From **N** Line **NE**

330 Ft. From **W** Line Quarter

MAY 6 1953

Ist. Report

Completion

Remarks

Petroleum Inc. - Contr.

Spudding Date

Drlg. Data **Wildcat**

8" @ 205 WOC

