


Ellis

KANSAS

SECTION 29 TOWNSHIP 12S RANGE 20W

WELL NO. #1 Groff

COMPANY Sterling Drlg.

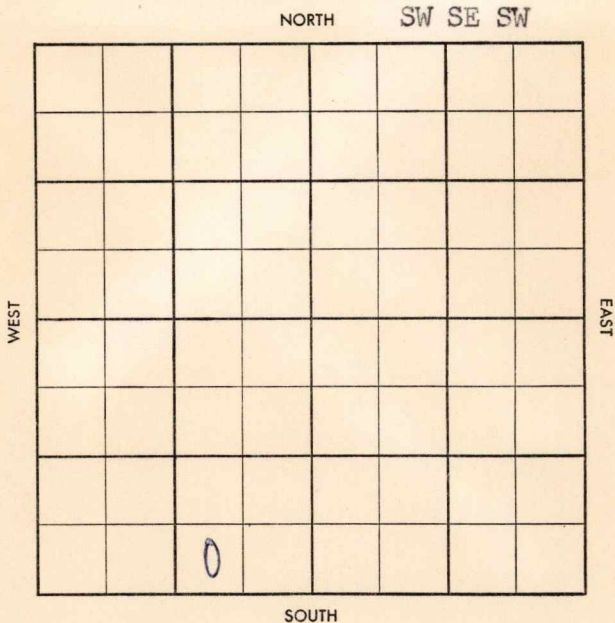

~~Ellis Pool~~

6 ✓

CO. Ellis ELEV. _____

SEC. 29 TWP. 12 RGE. 20W

COMPANY Sterling Drlg. No. 1

DEC 11 1957	
FIRST REPORT	
0	

FARM Groff

LOC. SW SE SW

Anhy 1570	

GEOL. _____

CONTR. Co. Tools

POOL Ellis

SPUD 12/7/57

8" @ 360 w/200 Drlg.
1964.

CO.

LSE.

NO.

SEC.

TWP.

RGE.

CO. Ellis ELEV 21980

SEC. 29 TWP. 12 RGE. 20W

COMPANY Sterling Drlg. Co. 1

CO.
ABANDONED
FEB 19 '58

FARM Groff

LOC. SW SE SW

Arhy 1570

DA

TD 3917

GEOL.

CONTR. Co. Tools

POOL Ellis

SPUD 12/7/57

8" w 360 w/200 Drlg.

1964. DEC 18 '57 Hb 3453

TR 3474 L 3489

BKC 3736 Chdly

e 3821 Sdy C 3857

DST 3858-65

60" 138' V40cm FP 40-50

BHP 1170/20' A-b 3890 RTD

3917 no log 5 1/2 3916

DEC 26 '57

JAN 2 '58 JAN 8 '58

16/3858-62

500A FC 370' Fld 14 hrs fine

\$ Ld

JAN 15 - JAN 22 '58

JAN 29 '58

FEB 5 '58

\$ 2 1/2 BOPK 80 p

P 9.28 BF pd 2090 W

p 5 BF pd 1090 W

FEB 19 '58

P 3.81 BF pd +3090 W

CO.
LSE