

Ellis

KANSAS

SECTION 31 TOWNSHIP 12S RANGE 20W

WELL NO. #2-Huber

COMPANY Artnell Co.

C E/2 E/2 NE

NORTH

WEST

EAST

SOUTH

								○	

Ellis

KANSAS


SEC. 31	TWP. 12 S	R. 20 W
------------	--------------	------------

WELL NO. # 2 Huber FARM

COMPANY Artnell Co.

CONTRACTOR Leben Drlg.
Ellis

_____ FT. FROM N. LINE
 _____ FT. FROM S. LINE
 _____ FT. FROM E. LINE
 _____ FT. FROM W. LINE

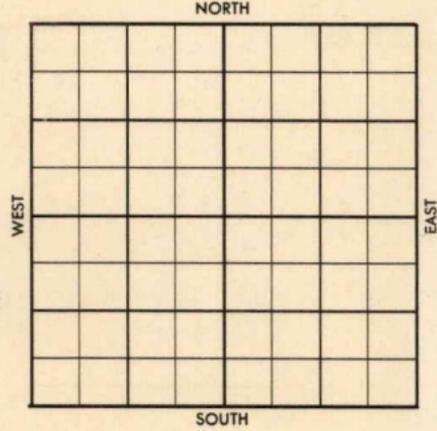

C E/2 E/2 NE

SDX-FO

1957	ELEVATION 2175' KB	REPORT
------	-----------------------	--------

7/17
 Comm. 7-13-57
 8" @ 367/225
 Drlg. 2065'

(FR Tkt)

County Ellis Elev. 2175 KB
 Sec. 31 Twp. 12 Rge. 20W
 Company Artnell Co.
 Farm Name Huber No. 2

TOPS	DEPTH	LOG	DATUM
Anh.			
Tp.			
H.			
Tr.			
Dg.			
Bl.			
L.			
K.C.			
B.K.C.			
Ce.			
C.			
M.			
M.			
K.			
Mz.			
Me.			
V.			
S.			
S.			
A.			
R.			
Pe.			
G.			
T.D.			

Loc. in Sec. C E $\frac{1}{2}$ E $\frac{1}{2}$ NE
 Geol. _____
 Contr. _____
Leben Drlg.
 Pool Ellis

FIRST REPORT
 JUL 17 '57

Date Comm. 7-13-57 SDX-FO
8" @ 367/225 drlg. 2065

JUL 19 1957
 M.M.

Co.
 Lse.
 No.
 Sec.
 T.
 R.

ELLIS

Elev. 2175 KB

31

12

Rgs. 20W

Arnell Co.

FarmName Huber

No. 2

TOPS	DEPTH	LOG	DATUM	Loc. in Sec.
Anh.				C E 1/2 B 1/2 NE
Tp.				
H. X	3422			
Tr.	3442			
Dg.				
BL.				
L.	3459			Geol.
K.C.				Contr.
B.K.C.	3711			
Ce.				Leben Drlg.
C. <i>Marm</i>	3740			
M.				Pool
M.				Ellis
K.				<div style="border: 2px solid red; padding: 5px; text-align: center;"> ABANDONED SEP 4 '57 </div>
Mz.				
Mq.				
V.				
S.				
S. X	3834			
A.				
R.				
Pf.				
G.				
T.D.	3840			

Date Comm.

7-13-57

SDX-FO

8" @ 367/225 drlg. 2065

JUL 24 '57 X Tops @ 3743 JUL 31 '57 X

5 1/2 e 3836 1/2 / 100 WOCT AUG 8 '57 CO

DD 3842 @ 3 Goph no/w

3/4 @ 14-Bwph 50g AUG 14 '57 X

CO 3839 4/3835-66 prep totst

AUG 21 '57 \$ 50 Gwph T.A. Hold for Pf

AUG 28 '57 SEP 4 '57 8/3835-37 1/2 no tst

2/3837-38 tst 5 G Acid wph

~~DEA~~ 3R CO 3838 6/3838

ME no tst DD 3842 8/

3840-43 notst DD 3849 tst

2 Bwph

DEA

31-12-20

CEYBYNE