

Woodson


Form 51-5M-2-29-34703

Map No. KANSAS Sec 6 Twp. 24 R. 14

Well No. 6 - Winter shield - Farm

Okla P & R Company

NORTH

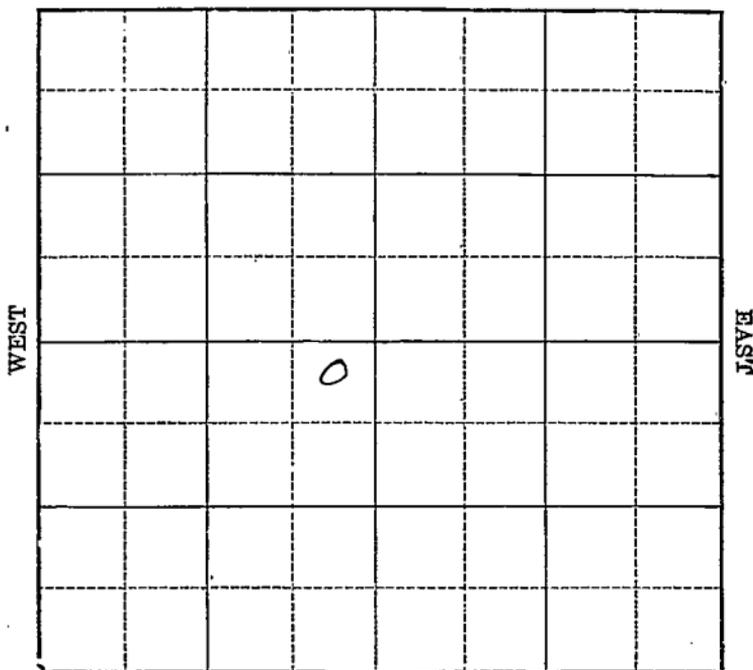

SOUTH

Location _____

Drilling Remarks _____

Rig Up _____

Drilling Remarks _____

RECORD

Cased _____ in. _____ ft.

Sand _____

Gas _____

Oil _____

Total Depth _____

PRODUCTION

1st 24 hrs. Nat. _____

1st 24 hrs. after shot _____

Gas _____ cu. ft. _____

Dry Hole _____

Abandoned _____

Woodson

MAP NO. *4ns* SEC. *6* TWP. *74* R. *14*

WELL NO. *6* *Wintersheis*
Oklaw P & R Co COMPANY

CONTRACTOR

**FIRST REPORTS
COMPLETED**

SECTION PLAT

_____ FT. FROM N. LINE
 _____ FT. FROM S. LINE
 _____ FT. FROM E. LINE
 _____ FT. FROM W. LINE

		o	

LOCATION _____

RIG UP _____

DRILLING AND REMARKS:

35 Bls.

RECORD

CASED _____ IN. _____ FT.

SAND *1712-1722*

GAS _____

OIL _____

TOTAL DEPTH *1722*

PRODUCTION

1ST 24 HRS. NAT. _____

1ST 24 HRS. AFTER SHOT _____

GAS _____ CU. FT.

DRY HOLE _____

ABANDONED _____

DATE

7/21/20

192

Sherwood

SCOUT