

Ellis **KANSAS**

Section 29 Township 12 Range 20W

Well No. 1 Zonella

Company Musgrove Petroleum

NORTH

WEST

EAST

0							

SOUTH

Ellis

KANSAS


Sec. 29 Twp. 12 R. 20 WWell No. # 1 Zonella FarmMusgrove Pet. CompanyMusgrove ContractorWildcat330 Ft. from N. Line

Ft. from S. Line

Ft. from E. Line

330 Ft. from W. Line

NW NW NW

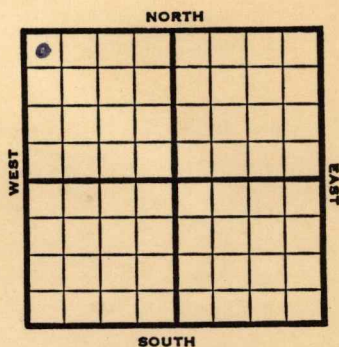

1952

Elv. 2230' REPORT

12/17

Spud 12-13-52

8" @ 173

Dr lg. 1470'

12/25

"

"

1/1

D&A HOLD

1/8

D&A HOLD

1/23

Spud 12-13-52 D & A T^u 3960'

8" @ 173

DST 3543-56 open 1 hr. rec 35' mud

DST 3846-80 open 1 hr. rec 430' SW

SSO B KC 3800 Marm 3846

Cong. 3906' Arb. 3918'

TD 3960' Lans. 3542' D & A

ABANDONED

County Ellis State KansasSec. 29 (Blk. 12 (Sur. 20W Map No. 20W)
(Twp.) (Rge.)Operator Musgrove Pet.Well No. 1 Farm ZonellaElev. _____ Location NW NW NW

0							

FIRST REPORT

330 Ft. From N Line NW330 Ft. From W Line Quarter1st. Report DEC 17 1952

Completion _____

Remarks _____

Musgrove - Contr.Spudding Date 12-13-52Drlg. Data Wildcat8" @ 173 drlg. 1470

J. G. McGEHEE

County Ellis State Kansas

Sec. 29 (Blk. Twp.) 12 (Sur. Rge.) 20W Map No.

Operator Musgrove Pet.

Well No. 1 Farm Zonella

Elev.	2230	Location	NW NW NW
-------	------	----------	----------

0

BANDONED

330 Ft. From N Line NW

330 Ft. From W Line Quarter

1st. Report

Completion JAN 23 1953

Remarks	Wildcat
---------	---------

Musgrove - Contr.

Spudding Date 12-13-52

Drig. Data D & A TD 3960

8" @ 173 DST 3543-56 open 1 hr. Rec.

35' mud DST 3846-80 open 1 hr. Rec.

430' SW SSO B KC 3800 Marm. 3846

Cong. 3906 Arb. 3918 TD 3960

Lans. 3542 D & A

J. G. McGEHEE