

KANSAS


FORM 51 5M 1-42 PETROL

Ellis

Section 31 Township 12 Range 20-W

Well No. #3 Bittel "A"

Company Darby

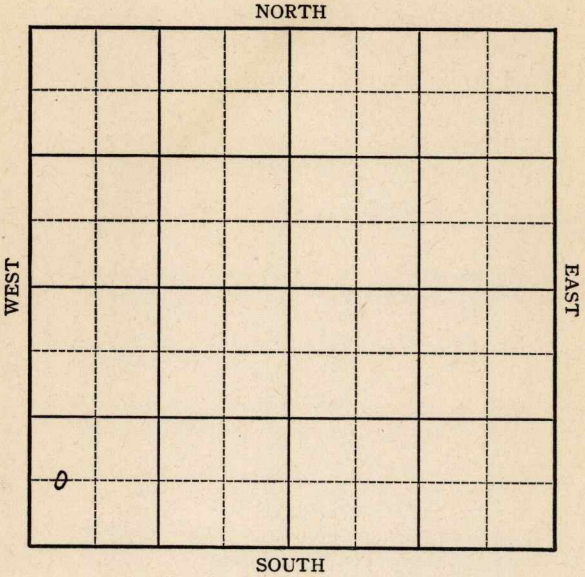

KANSAS

Ellis

Sec. 31 Twp. 12 R. 20-W

Well No. #3 Bittel "A" Farm

Darby Company

Ellis


 Ft. from N. Line

660 Ft. from S. Line

 Ft. from E. Line

330 Ft. from W. Line

Elev. 2191

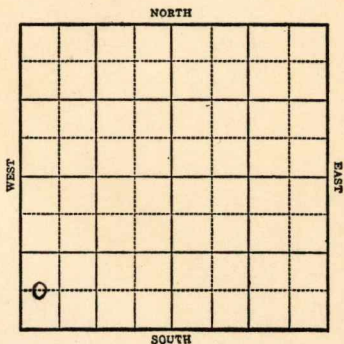

1943

R E P O R T

7/14 Surface hole

7/21 10" @ 120
Anhy 1539
Drlg. 3625'

7/28 **Lans 3457**
BKC 3705
Arb 3820-23 T.D.
5" @ 3822 RUST SO

8/4 T.D. 3853-2900' oil in 15 hrs.

8/11 **Arb 3818**
5" @ 3820
Pump 583 Pot.
T.D. 3853
Gravity 36

COMPLETED

Ellis

Map No. **KANSAS** Sec. 31 Twp. 12 R. 20W

Well No. 3 Bittel "A"

Darby

Company

FIRST REPORT

Contractor

C WL SW SW

SECTION PLAT

Ft. from N. Line

660 Ft. from S. Line

Ft. from E. Line

330 Ft. from W. Line

6			

ELLIS POOL

Location

Rig up

Drilling and Remarks:

Surface Hole

RECORD

Cased _____ in., _____ ft.

Sand _____

Gas _____

Oil _____

Total Depth _____

PRODUCTION

1st 24 hrs. Nat. _____

1st 24 hrs. after shot _____

Gas _____ Cu. Ft.

Dry Hole _____

Abandoned _____

Date

JUL 14 1943 19

S. J. LEWIS Scout

Ellis

KANSAS

Map No. 70 Sec. 31 Twp. 12 R. 20W

Well No. 3 Bittel "A"

Darby

Company

COMPLETED

Contractor

C WL SW SW

SECTION PLAT

0			

Ft. from N. Line

660

Ft. from S. Line

Ft. from E. Line

330

Ft. from W. Line

ELLIS POOL

Location _____

Rig up _____

Drilling and Remarks:

CUY 3818

5" @ 3820

Pump. 573 Ft.

36° S

RECORD

Cased _____ in., _____ ft.

Sand _____

Gas _____

Oil _____

Total Depth 3859

PRODUCTION

1st 24 hrs. Nat. _____

1st 24 hrs. after shot _____

Gas _____ Cu. Ft.

Dry Hole _____

Abandoned _____

Date

AUG 1 1 1943

19

S. J. LEWIS

Scout