

KANSAS


FORM 51 5M 1-42 PETROL

Ellis

Section 31 Township 12 Range 20-W

Well No. #2 Huber "A"

Company Darby

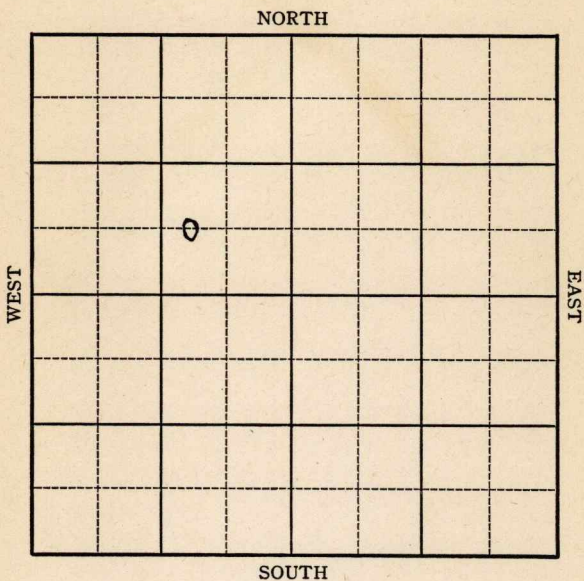

KANSAS

Ellis

Sec. 31 Twp. 12 R. 20-W

Well No. #2 Huber "A" Farm


Darby Company

 Ft. from N. Line

660 Ft. from S. Line

990 Ft. from E. Line

 Ft. from W. Line

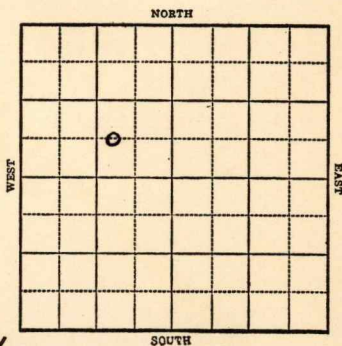

Elw. 2181

1943

R E P O R T

5/5	Location
5/12	Derrick
5/19	10" @ 121 WOC.
5/26	Any 1529 Drlg. 3235'
6/2	Lans 3460 Arb 3838-43 T.D. Sat. 5"t@ 3838 Rust.
6/9	T.D. 3448-2100' oil 4 hrs. Pump 173' oil in 6 hrs.
6/16	Arb. 3838 5"t@ 3838' T.D. 3848' Pump 616 Pot. Gravity 36

COMPLETED

KANSAS

Ellis

Map No. 70 Sec. 31 Twp. 12 R. 20WWell No. 2 Huber "A"

Darby

Company

FIRST REPORT

Contractor

C WL SE NW

SECTION PLAT

 Ft. from N. Line660 Ft. from S. Line990 Ft. from E. Line Ft. from W. Line

ELLIS POOL

Location XXXXRig up

Drilling and Remarks:

RECORD

Cased in., ft.Sand Gas Oil Total Depth

PRODUCTION

1st 24 hrs. Nat. 1st 24 hrs. after shot Gas Cu. Ft.Dry Hole Abandoned

Date

MAY 5 1943 19

S. J. LEWIS

Scout

KANSAS

Ellis

Map No. 10 Sec. 31 Twp. 12 R. 20WWell No. 2 Huber "A"

Darby


Company

COMPLETED

Contractor

C WL SE NW

SECTION PLAT

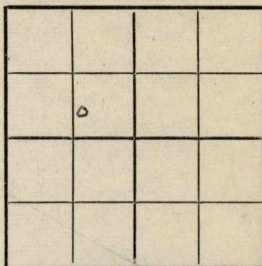

Ft. from N. Line

660

Ft. from S. Line

990

Ft. from E. Line

Ft. from W. Line

ELLIS POOL

RECORD

Location

Cased _____ in., _____ ft.

Rig up

Sand _____

Drilling and Remarks:

Gas _____

Oil _____

Total Depth 3848

PRODUCTION

1st 24 hrs. Nat. _____

1st 24 hrs. after shot _____

Gas _____ Cu. Ft.

Dry Hole _____

Abandoned _____

Date

JUN 16 1943

19

S. J. LEWIS Scout

*Oil 3838.**5" @ 3838.**Pump. 616 Pa X**36° Gr*