


Section 31 Township 12 Range 20-W

Well No. #3 Huber "A"

Company Darby Pet.

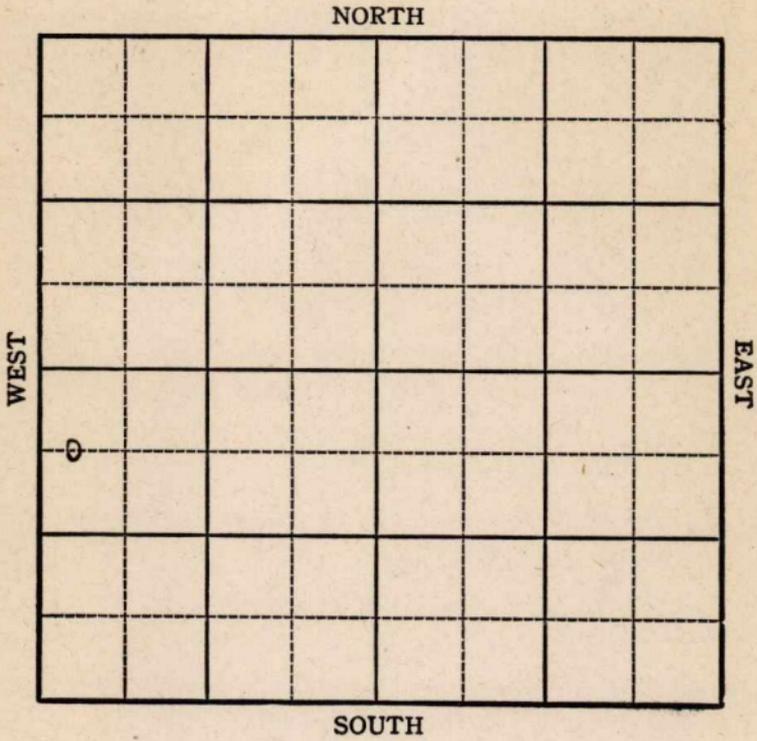

Sec. 31 Twp. 12 R. 20-W

Well No. #3 Huber "A" Farm


Darby Petroleum Company

660 Ft. from N. Line

_____ Ft. from S. Line

_____ Ft. from E. Line

330 Ft. from W. Line

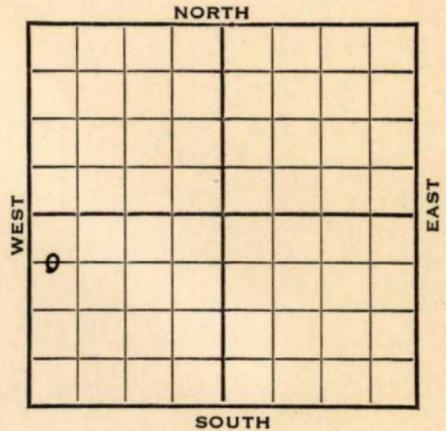

Ues. 2199

1943

REPORT

- 8/18 Rotary
- 8/25 "
- 9/1 10" @ 118
Anhy 1534
- 9/8 Drlg. 2560'
Drlg. 3600
- 9/15 **Congl 3814**
Arb 3855
T.D. 3861 Sat
7" @ 3859
RUST
- 9/22 **Arb 3855**
7" @ 3859
Pump 235 Pot.
Gravity 36
T.D. 3872½

COMPLETED

Ellis

KANSAS

Map No. 70 Sec. 31 Twp. 12 R. 20W

Well No. 3 Huber "A"

Darby Petroleum Company

FIRST REPORT Contractor

SECTION PLAT

660 **C W L NW SW**
Ft. from N. Line

_____ Ft. from S. Line

_____ Ft. from E. Line

330 Ft. from W. Line

o			

EllisyPool

Location _____

Rig up _____

Drilling and Remarks:

Rotary

RECORD

Cased _____ in., _____ ft.

Sand _____

Gas _____

Oil _____

Total Depth _____

PRODUCTION

1st 24 hrs. Nat. _____

1st 24 hrs. after shot _____

Gas _____ Cu. Ft.

Dry Hole _____

Abandoned _____

Date

AUG 18 1943

19

S. J. LEWIS Scout

KANSAS

Map No. 70 Sec. 31 Twp. 12 R. 20W

Well No. 3 Huber "A"

Darby Petroleum Company

COMPLETED Contractor

C W L NW SW

SECTION PLAT

660 Ft. from N. Line

_____ Ft. from S. Line

_____ Ft. from E. Line

330 Ft. from W. Line

Ellis Pool

Location _____

Rig up _____

Drilling and Remarks:

Cer X 3855
7" C 3859
Pump 235 P.D.
86° Gr

RECORD

Cased _____ in., _____ ft.

Sand _____

Gas _____

Oil _____

Total Depth 3822 1/2

PRODUCTION

1st 24 hrs. Nat. _____

1st 24 hrs. after shot _____

Gas _____ Cu. Ft.

Dry Hole _____

Abandoned _____

Date

SEP 22 1943 19 _____

S. J. LEWIS Scout