


Section 3 Township 17 Range 11-W

Well No. #3 Burmeister

Company Shell

NORTH Kraft Pool

10

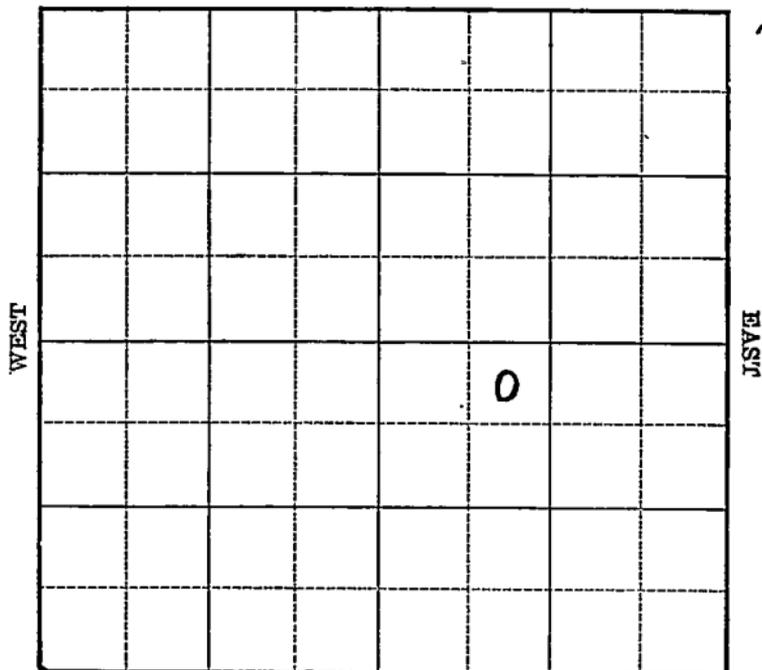

SOUTH

Sec. 3 Twp. 17 R. 11-W

Well No. #3 Burmeister Farm

Shell Company


(Kraft)

330 Ft. from N. Line

_____ Ft. from S. Line

_____ Ft. from E. Line

987 Ft. from W. Line

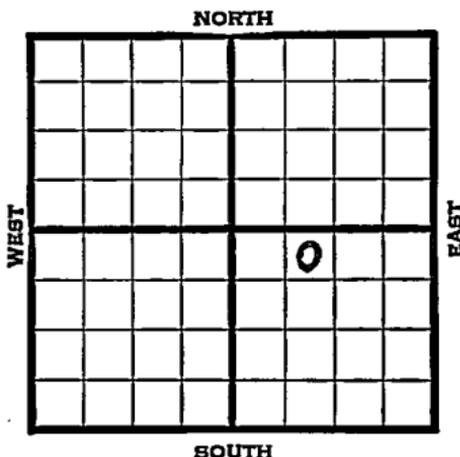

1939	REPORT
8/9	Location
8/17	8" - 313' Drlg. 840'
8/24	Drlg. 2889'
8/31	Lans. 3043' Cong. 3310'
	Arb. 3354' T.D. 3358'
	4" - 3355' RUST.
9/7	T.D. 3375' 2000 acid.
	Swab 110 oil 4 hours.
9/14	" " " "
9/20	Arb. 3354'
	4" - 3355'
	T.D. 3375'
	2000 acid.
	Echometer potential 992 oil &
	14 water.
	COMPLETED

Map No. _____ Sec. 3 Twp. 17 R. 11W

Well No. 3 Burmeister

Shell

Company

Contractor

FIRST REPORT

NE NW SE

330 Ft. from N. Line

_____ Ft. from S. Line

_____ Ft. from E. Line

987 Ft. from W. Line

SECTION PLAT

		0	

KRAFT POOL

Location X

Rig up _____

Drilling and Remarks:

RECORD

Cased _____ in., _____ ft.

Sand _____

Gas _____

Oil _____

Total Depth _____

PRODUCTION

1st 24 hrs. Nat. _____

1st 24 hrs. after shot _____

Gas _____ Cu. Ft.

Dry Hole _____

Abandoned _____

Date

AVG 2 1939

19

S. J. LEWIS Scout

Barton **KANSAS**

Map No. _____ Sec. **3** Twp. **17** R. **11W**

Well No. **3** **Burmeister**

Shell

Company

Contractor

COMPLETED

SECTION PLAT

NE NW SE

330 Ft. from N. Line

_____ Ft. from S. Line

_____ Ft. from E. Line

987 Ft. from W. Line

		o	

KRAFT POOL

RECORD

Location _____

Cased _____ in., _____ ft.

Rig up _____

Sand _____

Drilling and Remarks: ^

Gas _____

Core 3354

Oil _____

4" C 3355

Total Depth **3375**

2000 acid

Echometer P & Y

PRODUCTION

1st 24 hrs. Nat. _____

1st 24 hrs. after shot _____

Gas _____ Cu. Ft.

992 oil 14 Water

Dry Hole _____

Abandoned _____

Date

SE 20 1939 19

S. I. I FWIS Scout