


Section 31 Township 12 Range 20W

Well No. #4 Huber "A"

Company Sunray Oil

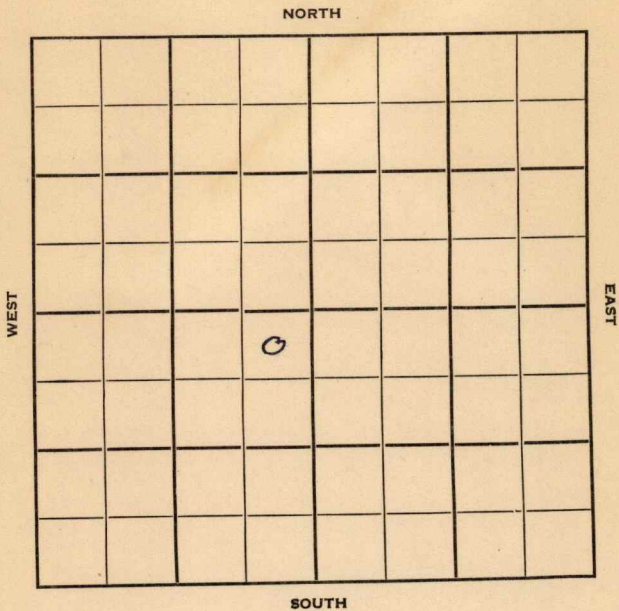

Ellis

KANSAS ✓

Sec. 31 Twp. 12 R. 20W

Well No. #4 Huber "A" Farm _____

Sunray Oil Company _____

Stickle Drlg. Contractor _____
Ellis Pool


330 Ft. from N. Line

_____ Ft. from S. Line

330 Ft. from E. Line

_____ Ft. from W. Line

NE NE SW

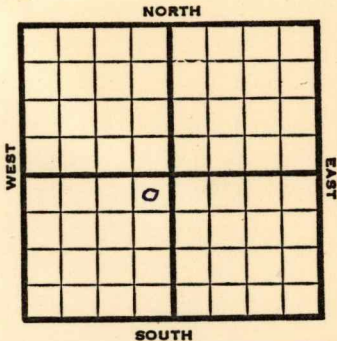

1952 **Elev. 2189'** REPORT

10/8 Cellar & Pits

10/15 8" @ 256
Drlg. 2575'

10/22 Topeka 3204', Heeb 3434', Lans
3457'
DST 3658-65 1 hr., 3' M
Drlg. 3772'

10/29 Arb. 3856' RTD 3859' 5" @ 3857
CO 3859' 2 gal OPH 1000 A

11/5 S/ 3 Boph & 3½ Bwph 8 hrs.

11/12 Spud 10-9-52 Oil well TD 3859'
8" @ 256 Top 3204' Heeb 3434'
Lans. 3457'

DST 3658-65 open 1 hr. rec 3' mud
Arb. 3856' TD 3859' 5" @ 3857
CO to 3859' 2 GOPH 1000 A
S/3.2 BOPH 3½ BWPB 8 hr.
Comp. 90 BOPD 22 BW

COMPLETED

