


Section 31 Township 12 Range 20-W

Well No. #1 Huber "B"

Company Darby

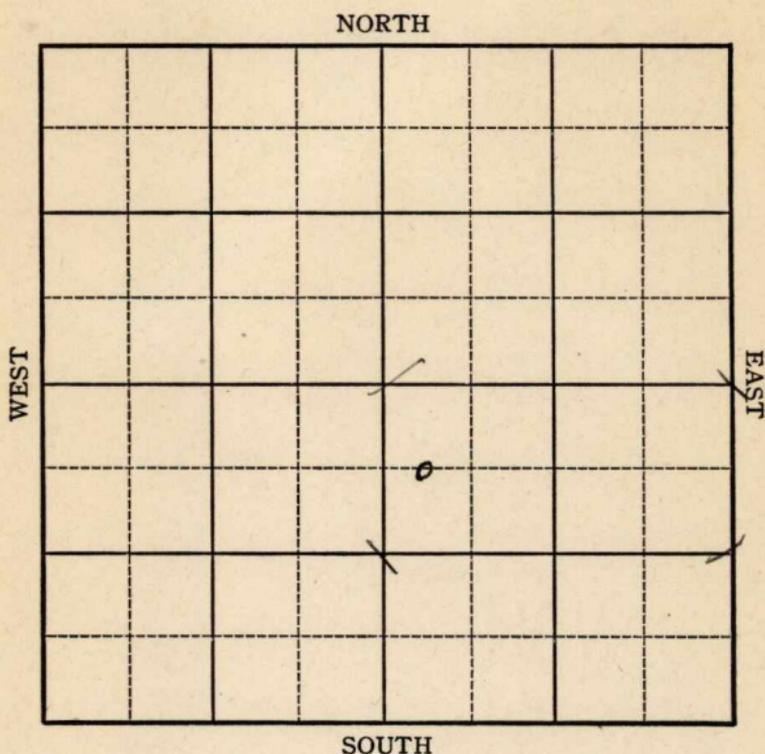

KANSAS

Ellis

Sec. 31 Twp. 12 R. 20-W

Well No. #1 Huber "B" Farm

Darby Company


660 Ft. from N. Line

_____ Ft. from S. Line

_____ Ft. from E. Line

330 Ft. from W. Line

Ellis Pool

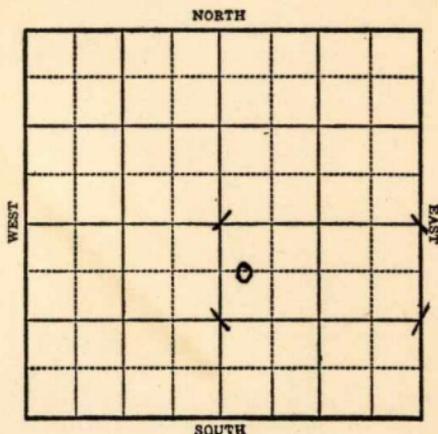

1943

Elev. 2182 R E P O R T

7/28 Derrick

8/4 Rotary

8/11 10" 119'
Anky 1529
Drlg. 2200'

8/18 **Arb 3831**
Sat 3835-40T.D.
7" @ 3835 Rust

8/25 T.D. 3845' 2950' oil

9/1 **Arb 3831**
7" @ 3835
Pump 810 Pot.
T.D. 3845
Gravity 36

COMPLETED

KANSAS

Map No. 70 Sec. 31 Twp. 12 R. 20W

Well No. 1 Huber "B"

Darby Company

FIRST REPORT Contractor

C WL NW SE


SECTION PLAT

660 Ft. from N. Line

_____ Ft. from S. Line

_____ Ft. from E. Line

330 Ft. from W. Line

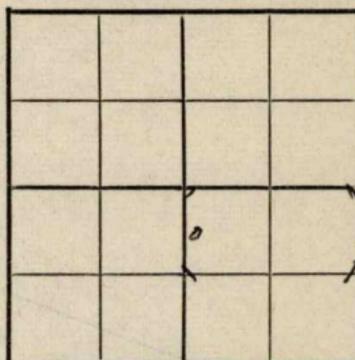

ELLIS POOL

Location _____

Rig up _____

Drilling and Remarks:

Derrick

RECORD

Cased _____ in., _____ ft.

Sand _____

Gas _____

Oil _____

Total Depth _____

PRODUCTION

1st 24 hrs. Nat. _____

1st 24 hrs. after shot _____

Gas _____ Cu. Ft.

Dry Hole _____

Abandoned _____

Date

JUL 28 1943

19

S. J. LEWIS Scout

KANSAS

Map No. 70 Sec. 31 Twp. 12 R. 20W

Well No. 1 Huber "B"

Darby Company

COMPLETED Contractor

C W L NW SE

660 Ft. from N. Line

_____ Ft. from S. Line

_____ Ft. from E. Line

330 Ft. from W. Line

Ellis Pool

SECTION PLAT

		o	

Location _____

Rig up _____

Drilling and Remarks:

Cor 3831
7" @ 3835.
Pump 510 Pst

36" @

RECORD

Cased _____ in., _____ ft.

Sand _____

Gas _____

Oil _____

Total Depth 3845

PRODUCTION

1st 24 hrs. Nat. _____

1st 24 hrs. after shot _____

Gas _____ Cu. Ft.

Dry Hole _____

Abandoned _____

Date

SEP 1 1943

19

S. J. LEWIS Scout