FORM 51 25M 8-50 WESTERN


Barton KANSAS

Section 3 Township 17 Range 11W

Well No. #3 Radenberg

Company Brooks Pierce

3

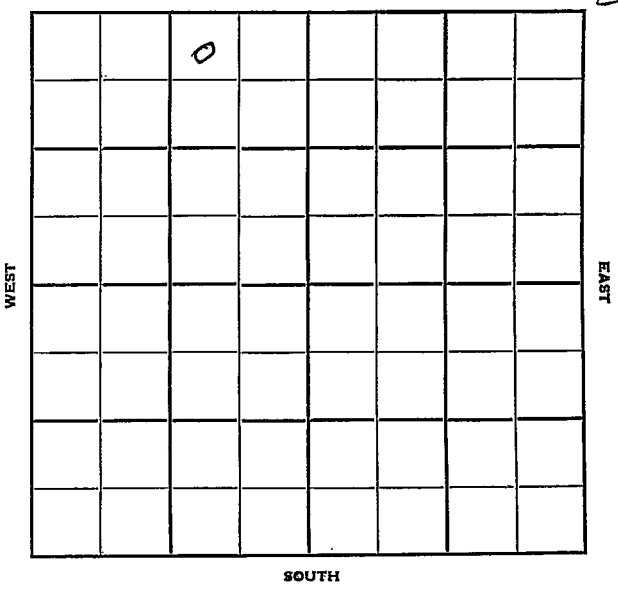

FORM 252-B
10M 10-50 PETROL

Barton

KANSAS

Sec. 3 Twp. 17 R. 11W

Well No. #3 Radenberg Farm

Brooks Pierce Company

Brooks Pierce Contractor

Kraft-Prusa Pool


330 Ft. from N. Line

Ft. from S. Line

990 Ft. from E. Line

Ft. from W. Line

NW NE NW

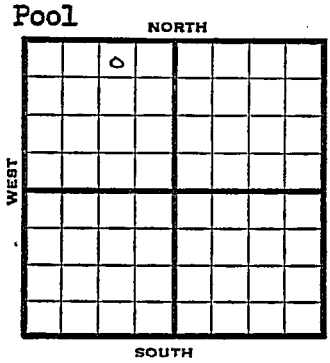

1951	Elev. 1892' REPORT
10/31	Location
1952 1/23	Spud 10-22-51 Oil Well TD 3339 8" @ 285 Arb. 3334-38 5" @ 3335 CO to 3336 S/38 bo 16 hr. DD 3339 Comp. 116 bopd **COMPLETED**

FORM 275 FOR SALE BY KANSAS BLUE PRINT CO.


County Barton State Kansas

Sec. 3 (Blk. Twp.) 17 (Sur. Rge.) 11W Map No.

Operator Brooks Pierce

Well No. 3 Farm Rädenberg

Elev. Location NW NE NW

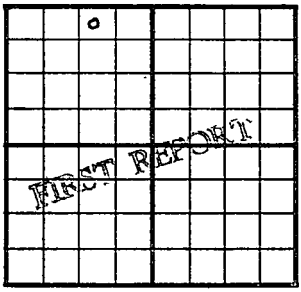

330 Ft. From N Line NW

990 Ft. From E Line Quarter

1st. Report OCT 31 1951

Completion

Remarks

Brooks Pieree - Contr.

Spudding Date

Drlg. Data Kraft-Prusa Pool

Location

J. E. TYRA

FORM 275 FOR SALE BY KANSAS BLUE PRINT CO.


County Barton State Kansas

Sec. 3 (Blk. Twp.) 17 (Sur. Rge.) 11W Map No.

Operator Brooks Pierce

Well No. 3 Farm Radenberg

Elev. 1892 Location NW NE NW

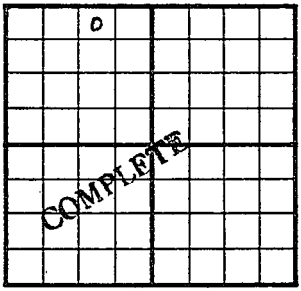

330 Ft. From N Line NW
1148
~~990~~ Ft. From E Line Quarter

1st. Report

Completion JAN 23 1952

Remarks Kraft-Prusa Pool

Brooks Pierce - Contr.

Spudding Date 10-22-51

Drlg. Data Oil well TD 3339

8" @ 285 Arb. 3334-38 5" @ 3335

CO to 3336 S/ 38 bo 15 hr. DD 3339

Comp. 116 bopd

J. G. McGEHEE