

KANSAS

Barton

Form 51-5M-7-40-Palace

Section 3 Township 17 Range 11-W

Well No. #4 Burmeister

Company Shell

NORTH Kraft Pool

9

							0

WEST

EAST

SOUTH

Sec. 3 Twp. 17 R. 11-W

Well No. #4 Burmeister Farm

Shell Company


(Kraft)

330 Ft. from N. Line

330 Ft. from S. Line

330 Ft. from E. Line

_____ Ft. from W. Line

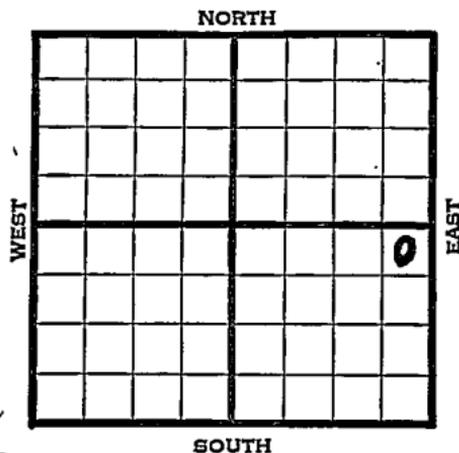

Elev. 1900

1941

REPORT

3/5

Location

3/13

8" - 338' Drlg. 985'

3/20

Drlg. 2822'

3/27

Topeka 2678' Lans. 3035'

Arb. 3301' 4" - 3302'

T.D. 3309' RUST.

4/2

T.D. 3320' 2000 acid.

Swab 231 oil 3 hours.

4/9

Arb. 3301'

4" - 3302'

T.D. 3320'

2000 acid.

Depthograph potential 42,186 bbl

Maximum 3000 bbls.

43.6 Gravity

COMPLETED

Map No. 5-5 Sec. 3 Twp. 17 R. 11W

Well No. 4 Burmeister

Shell

Company

~~FIRST REPORT~~

Contractor

SECTION PLAT

NE SE

330 Ft. from N. Line

0 Ft. from S. Line

330 Ft. from E. Line

_____ Ft. from W. Line

			o

KRAFT POOL

Location X

Rig up _____

Drilling and Remarks:

RECORD

Cased _____ in., _____ ft.

Sand _____

Gas _____

Oil _____

Total Depth _____

PRODUCTION

1st 24 hrs. Nat. _____

1st 24 hrs. after shot _____

Gas _____ Cu. Ft.

Dry Hole _____

Abandoned _____

Date

MAR 5 1941 19

S. J. LEWIS

Scout

Don - Please have scout check Ft. Meas.

Pittman

Misc. Small Maps	<i>DM</i>
Cards	<i>DM</i>
Tracing	<i>DM</i>
France Map	<i>DM</i>
Scarborough Map	<i>DM</i>
Moody Map	<i>DM</i>
Geological Dept.	<i>DM</i>
Moody Flat Book	<i>DM</i>

Map No. 55 Sec. 3 Twp. 17 R. 11WWell No. 4 Burmeister

Shell

Company

~~COMPLETED~~

Contractor

SECTION PLAT

NE SE

_____ Ft. from N. Line

330 Ft. from S. Line330 Ft. from E. Line

_____ Ft. from W. Line

			o

KRAFT POOL

Location _____

Rig up _____

Drilling and Remarks:

*Cr & 3301**4" @ 3302.**2000 acid**Sept 28 42186**Max 3000**43 1/2 ft*

RECORD

Cased _____ in., _____ ft.

Sand _____

Gas _____

Oil _____

Total Depth 3320

PRODUCTION

1st 24 hrs. Nat. _____

1st 24 hrs. after shot _____

Gas _____ Cu. Ft.

Dry Hole _____

Abandoned _____

Date

APR 9 1941 19S. J. LEWIS

Scout