

KANSAS


Barton

FORM 51 SM 2-38 TPCO.

Section 3. Township 17 Range 11-W

Well No. #4 Disque

Company Texas

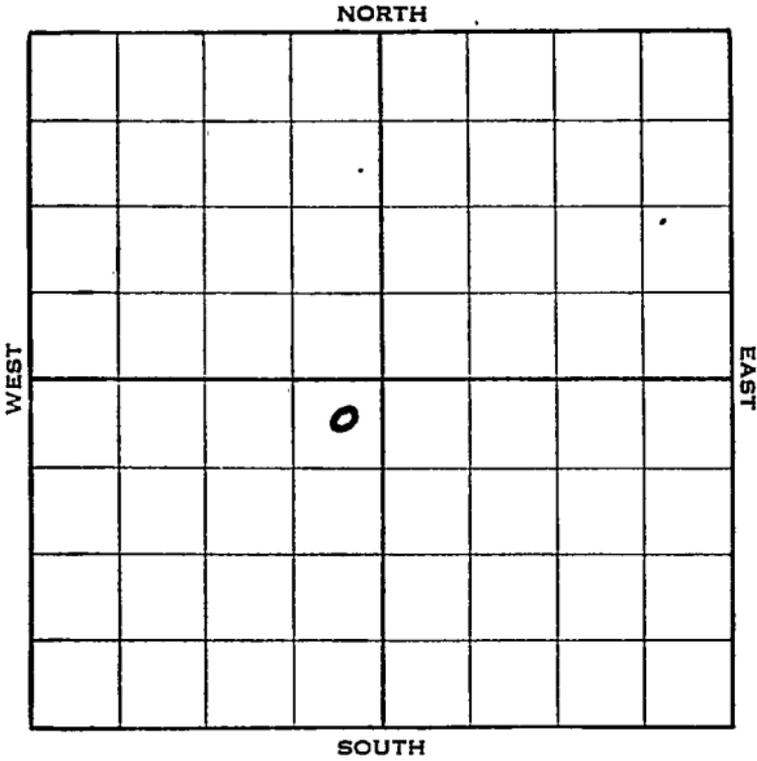

Sec. 3 Twp. 17 R. 11-W

Well No. #4 Disque Farm \_\_\_\_\_  
Texas Company \_\_\_\_\_


330 Ft. from N. Line

\_\_\_\_\_ Ft. from S. Line

330 Ft. from E. Line

\_\_\_\_\_ Ft. from W. Line

Elev. 1914

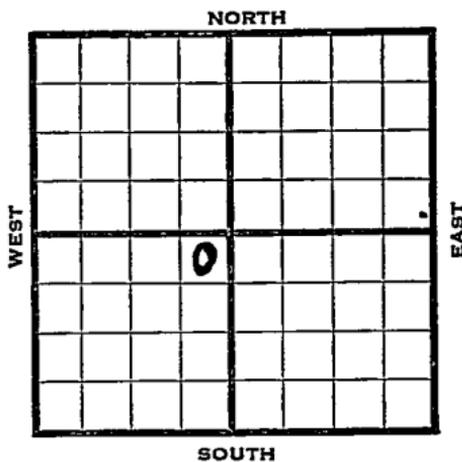

1938	REPORT
4/20	Cellar.
4/29	R. R.
5/6	10" @ 304'. Drlg. 735'.
5/12	Drlg. 2415'.
5/20	Arb. 3330-33' T.D. 7" @ 3331'. S.O. WOO.
5/25	7" @ 3331'.
	Arb. 3330'.
	T.D. 3374'.
	1000 acid.
	Potential 1560 bbls.
	2½% water.
	COMPLETED

Barton **KANSAS**

Map No. 53 Sec. 3 Twp. 17 R. 11W

Well No. 4 Disque

Texas

Company

Contractor

**FIRST REPORT**

**NE SW**

330 Ft. from N. Line

\_\_\_\_\_ Ft. from S. Line

330 Ft. from E. Line

\_\_\_\_\_ Ft. from W. Line

**SECTION PLAT**

	0		

Location \_\_\_\_\_

Rig up \_\_\_\_\_

Drilling and Remarks:

**Cellar**

**RECORD**

Cased \_\_\_\_\_ in., \_\_\_\_\_ ft.

Sand \_\_\_\_\_

Gas \_\_\_\_\_

Oil \_\_\_\_\_

Total Depth \_\_\_\_\_

**PRODUCTION**

1st 24 hrs. Nat. \_\_\_\_\_

1st 24 hrs. after shot \_\_\_\_\_

Gas \_\_\_\_\_ Cu. Ft.

Dry Hole \_\_\_\_\_

Abandoned \_\_\_\_\_

Date

APR 20 1938

H. D. Hatfield

Scout

Map No. 55 Sec. 3 Twp. 17 R. 11W

Well No. 4 Disque

Texas

Company \_\_\_\_\_

Contractor \_\_\_\_\_

**COMPLETED**

NE SW

330 Ft. from N. Line

\_\_\_\_\_ Ft. from S. Line

330 Ft. from E. Line

\_\_\_\_\_ Ft. from W. Line

**SECTION PLAT**

	0		

Location \_\_\_\_\_

Rig up \_\_\_\_\_

Drilling and Remarks:

*1000 acid*

*POT 1560*

*2 1/2 90 w/*

**RECORD**

Cased 7 in., 333/ft.

Sand Ar-b 3330

Gas \_\_\_\_\_

Oil \_\_\_\_\_

Total Depth 3374

**PRODUCTION**

1st 24 hrs. Nat. \_\_\_\_\_

1st 24 hrs. after shot \_\_\_\_\_

Gas \_\_\_\_\_ Cu. Ft.

Dry Hole \_\_\_\_\_

Abandoned \_\_\_\_\_

Date

MAY 25 1938

19

H. D. Hatfield

Scout