

# KANSAS

Form 51-5M-7-40-Palace

Barton


Section 3 Township 17 Range 11-W

Well No. #7 Disque

Company Texas

NORTH Kraft Pool

//

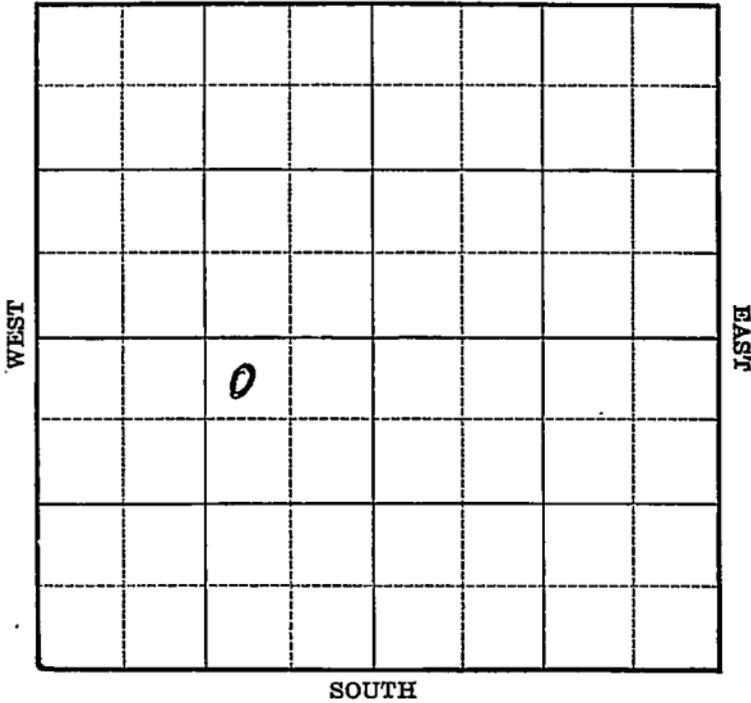





Map No. 55 Sec. 3 Twp. 17 R. 11W

Well No. 7 Disque

Texas

Company

~~COMPLETED~~

Contractor

NW NE SW

SECTION PLAT

	o		

330 Ft. from N. Line

\_\_\_\_\_ Ft. from S. Line

990 Ft. from E. Line

\_\_\_\_\_ Ft. from W. Line

KRAFT POOL

Location \_\_\_\_\_

RECORD

Rig up \_\_\_\_\_

Cased \_\_\_\_\_ in., \_\_\_\_\_ ft.

Drilling and Remarks:

Sand \_\_\_\_\_

*Ar 8296.*

Gas \_\_\_\_\_

*7" C 8296*

Oil \_\_\_\_\_

*Depth. 885028*

Total Depth 3806

*Max 3000*

PRODUCTION

*48.5 Gr.*

1st 24 hrs. Nat. \_\_\_\_\_

1st 24 hrs. after shot \_\_\_\_\_

Gas \_\_\_\_\_ Cu. Ft.

Dry Hole \_\_\_\_\_

Abandoned \_\_\_\_\_

Date

S. J. LEWIS

DEC 23 1940 19

Scout