

# KANSAS


Barton

Form 51-5M-7-40-Palace

Section 3 Township 17 Range 11-W

Well No. #8 Disque

Company Texas

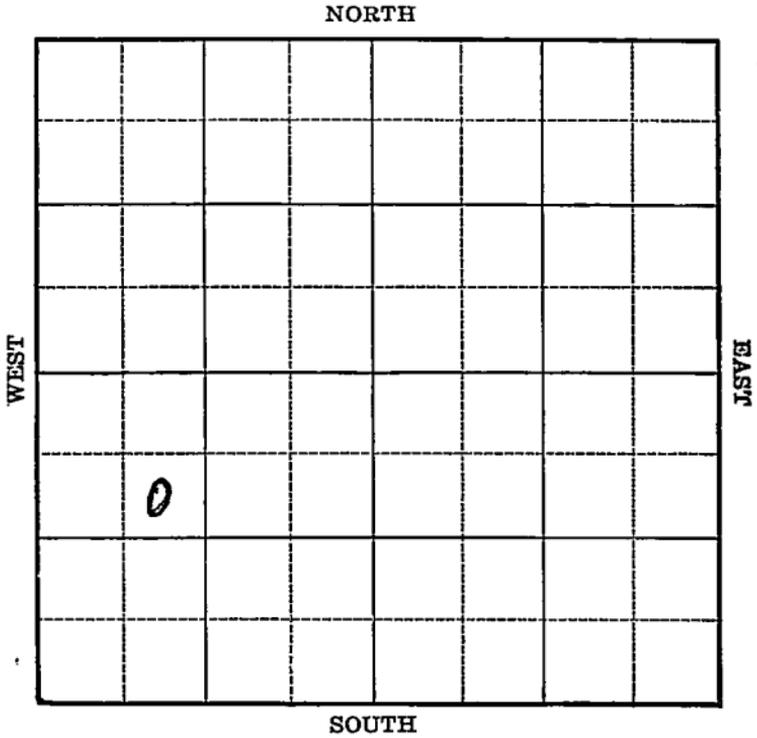



Map No. 55 Sec. 3 Twp. 17 R. 11WWell No. 8 Disque

Texas

Company

~~FIRST REPORT~~

Contractor

SE NW SW

## SECTION PLAT


990 Ft. from N. Line

\_\_\_\_\_ Ft. from S. Line

\_\_\_\_\_ Ft. from E. Line

990 Ft. from W. Line

KRAFT POOL

Location X

Rig up \_\_\_\_\_

Drilling and Remarks:

## RECORD

Cased \_\_\_\_\_ in., \_\_\_\_\_ ft.

Sand \_\_\_\_\_

Gas \_\_\_\_\_

Oil \_\_\_\_\_

Total Depth \_\_\_\_\_

## PRODUCTION

1st 24 hrs. Nat. \_\_\_\_\_

1st 24 hrs. after shot \_\_\_\_\_

Gas \_\_\_\_\_ Cu. Ft.

Dry Hole \_\_\_\_\_

Abandoned \_\_\_\_\_

Date

DEC 30 1940 19

S. J. LEWIS

Scout

Map No. 55 Sec. 3 Twp. 17 R. 11W

Well No. 8 Disque

Texas Company

COMPLETED Contractor

SECTION PLAT

SE NW SW  
990 Ft. from N. Line  
 \_\_\_\_\_ Ft. from S. Line  
 \_\_\_\_\_ Ft. from E. Line  
990 Ft. from W. Line


KRAFT POOL

Location \_\_\_\_\_

Rig up \_\_\_\_\_

Drilling and Remarks:

*Cr & 3289*  
*7" @ 3289*  
*10000 ad*  
*Depth 2046 P & S*  
  
*43 6/8*

RECORD

Cased \_\_\_\_\_ in., \_\_\_\_\_ ft.  
 Sand \_\_\_\_\_  
 Gas \_\_\_\_\_  
 Oil \_\_\_\_\_  
 Total Depth 3307

PRODUCTION

1st 24 hrs. Nat. \_\_\_\_\_  
 1st 24 hrs. after shot \_\_\_\_\_  
 Gas \_\_\_\_\_ Cu. Ft.  
 Dry Hole \_\_\_\_\_  
 Abandoned \_\_\_\_\_

Date

FEB 5 1941 19 S. I. LEWIS Scout