


KANSAS

Barton

Section 3 Township 17 Range 11-W

Well No. #14 Frees

Company Derby

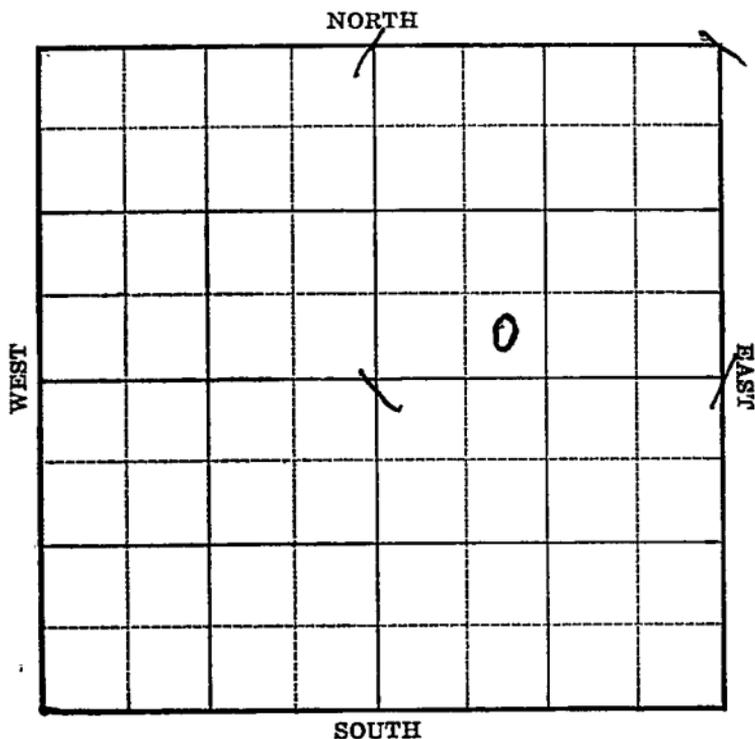

Sec. 3 Twp. 17 R. 11-W

Well No. #14 Frees Farm _____

Derby Company _____


_____ Ft. from N. Line

330 Ft. from S. Line

_____ Ft. from E. Line

990 Ft. from W. Line

Elev. 1918

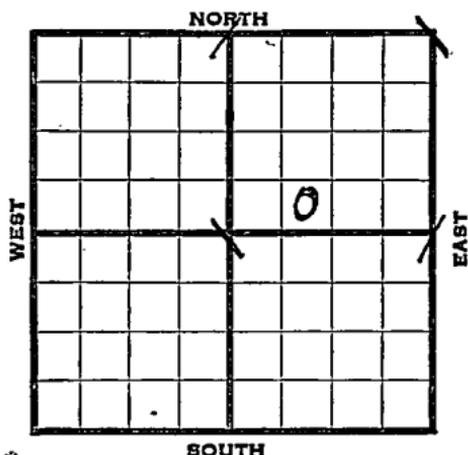

Year	REPORT
1938	
12/7	Cellar.
12/15	"
12/23	"
12/30	"
1939	
1/6	R U R
1/13	10" - 327'. WOC.
1/20	Drlg. 2150'.
1/27	Lans. 3060'.
	Drlg. 3295'.
2/3	B. K. C. 3328 $\frac{1}{2}$ '.
	Arb. 3367-71' T. D. S. O.
	7" - 3367'.
2/10	Pay 3378-79'.
	Swab 4 oil per hour @ 3383'.
	1000 acid. Swab 27 oil in 9
	hrs. @ 3388'. Drlg. 3390'.
2/17	2 B.W. 3410-14 $\frac{1}{2}$ ' T.D.
	2800' oil. Potential 146 bbls.
	Will P. B.

OVER

1939

2/23

P. B. to 3395'.
Shot 10 qts. 3376-86'.
2500' oil. C. O.

3/1

7" - 3367'
Arb. 3367'
T. D. 3414½'
P. B. 3395'
Shot 10 qts. 3376-86'
Pump 147 bbls. 8 hours.
Potential 442 bbls.

COMPLETED

Barton

KANSAS

Map No. 55 Sec. 3 Twp. 17 R. 11WWell No. 14 FreesDerby

Company

Contractor

FIRST REPORT

SE SW NE

 Ft. from N. Line330 Ft. from S. Line Ft. from E. Line990 Ft. from W. Line

SECTION PLAT

Location Rig up

Drilling and Remarks:

Cellar

RECORD

Cased in., ft.Sand Gas Oil Total Depth

PRODUCTION

1st 24 hrs. Nat. 1st 24 hrs. after shot Gas Cu. Ft.Dry Hole Abandoned

Date

DEC 7 - 1938 19 H. D. Hatfield Scout

Map No. 55 Sec. 3 Twp. 17 R. 11WWell No. 14 FreesDerby

Company

Contractor

COMPLETED

SE SW NE

 Ft. from N. Line330 Ft. from S. Line Ft. from E. Line990 Ft. from W. Line**SECTION PLAT**

		0	

KRAFT POOLLocation Rig up

Drilling and Remarks:

*P.B. 3395
shot 10 gts
3376-86
P-147/8
Pot 442*

RECORDCased 7 in., 3367 ft.Sand Arb 3367Gas Oil Total Depth 3414 1/2**PRODUCTION**1st 24 hrs. Nat. 1st 24 hrs. after shot Gas Cu. Ft.Dry Hole Abandoned

Date

MAR 1 - 1939 19

H. D. Hatfield Scout