

KANSAS

Form 51-5M-7-40-Palace

Barton


Section 3 Township 17 Range 11-W

Well No. #5 Frees

Company Derby Oil

NORTH Kraft Pool

8

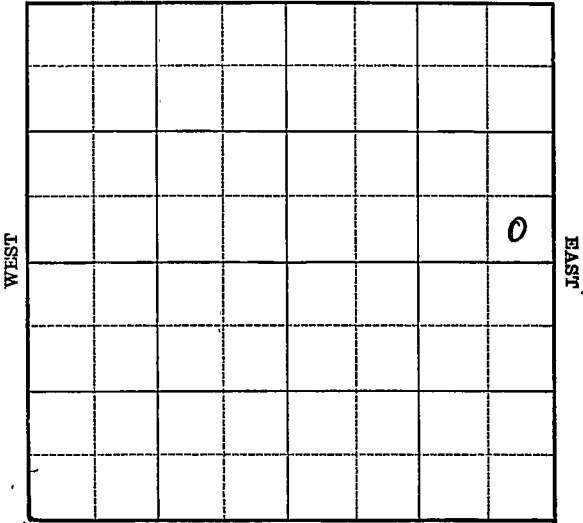

SOUTH

Sec. 3 Twp. 17 R. 11-W

Well No. #5 Frees Farm

Derby Oil Company

(Kraft)


_____ Ft. from N. Line

330 Ft. from S. Line

330 Ft. from E. Line

_____ Ft. from W. Line

Elev. 1907

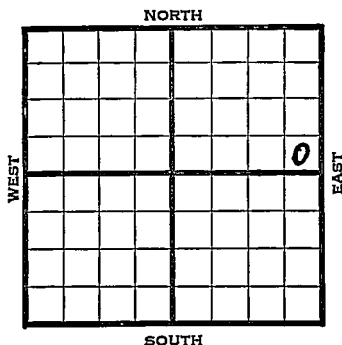

1941	REPORT
3/26	Location
4/2	Surface hole.
4/10	7" - 366' Drlg. 3097'
4/18	Lans. 3052' Cong. 3322'
	Arb. 3358' 4½" - 3359'
	T.D. 3369' Swab 17 bbls. in 2 hours.
4/24	1000 acid. Swab 184 oil 5 hrs, plus 4% water.
4/30	Arb. 3351'
	4" - 3359'
	T.D. 3369'
	1000 acid.
	Depthograph potential 972 bbls. plus 8% water.
	43.6 Gravity
	COMPLETED

Map No. 53 Sec. 3 Twp. 17 R. 11W

Well No. 5 Frees

Derby Oil Company

Contractor

FIRST REPORT

SECTION PLAT

SE NE

_____ Ft. from N. Line

330 Ft. from S. Line

330 Ft. from E. Line

_____ Ft. from W. Line

			o

KRAFT POOL

Location X

Rig up _____

Drilling and Remarks:

RECORD

Cased _____ in., _____ ft.

Sand _____

Gas _____

Oil _____

Total Depth _____

PRODUCTION

1st 24 hrs.-Nat. _____

1st 24 hrs. after shot _____

Gas _____ Cu. Ft.

Dry Hole _____

Abandoned _____

Date

MAR 26 1941 19

S. J. LEWIS Scout

Map No. 55 Sec. 3 Twp. 17 R. 11W

Well No. 5 Frees

Derby Oil Company

Contractor

COMPLETED

SE NE

 Ft. from N. Line

330 Ft. from S. Line

330 Ft. from E. Line

 Ft. from W. Line

SECTION PLAT

KRAFT POOL

Location

Rig up

Drilling and Remarks:

Cr & 3351
4" C 3359
1000 acid
Sept 20 & 972
& 8% water

4136 gr

RECORD

Cased in., ft.

Sand

Gas

Oil

Total Depth 3369"

PRODUCTION

1st 24 hrs. Nat.

1st 24 hrs. after shot

Gas Cu. Ft.

Dry Hole

Abandoned

Date

APR 30 1941

19

S. J. LEWIS Scout