

KANSAS

Form 51-5M-7-40-Palace

Barton

Section 3 Township 17 Range 11-W

Well No. #6 Disque

Company Texas

NORTH Kraft Pool

WEST								EAST
SOUTH								

0

13

Sec. 3 Twp. 17 R. 11-W

Well No. #6 Disque Farm

Texas

Company

(Kraft)

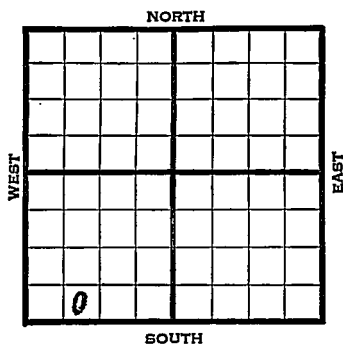
Ft. from N. Line

330 Ft. from S. Line

Ft. from E. Line

990 Ft. from W. Line

Elev. 1871

[illegible]

Map No. 55 Sec. 3 Twp. 17 R. 11WWell No. 6 DisqueTexas

Company

Contractor

FIRST REPORT

SECTION PLAT

SE SW SW
Ft. from N. Line330 Ft. from S. Line

Ft. from E. Line

990 Ft. from W. Line

KRAFT POOL

Location X

Rig up

Drilling and Remarks:

Derrick

RECORD

Cased _____ in., _____ ft.

Sand _____

Gas _____

Oil _____

Total Depth _____

PRODUCTION

1st 24 hrs. Nat. _____

1st 24 hrs. after shot _____

Gas _____ Cu. Ft.

Dry Hole _____

Abandoned _____

Date

NOV 6 1940 19

S. J. LEWIS Scout

Map No. 55 Sec. 3 Twp. 17 R. 11WWell No. 6 DisqueTexas

Company

Contractor

COMPLETED

SE SW SW

 Ft. from N. Line330 Ft. from S. Line Ft. from E. Line990 Ft. from W. Line

KRAFT POOL

SECTION PLAT

Location Rig up

Drilling and Remarks:

*Cor & 3295**7" @ 3296**Dep & 3496**Max 3000**38 1/2 Hr.***RECORD**Cased in., ft.Sand Gas Oil Total Depth 3304 1/2**PRODUCTION**1st 24 hrs. Nat. 1st 24 hrs. after shot Gas Cu. Ft.Dry Hole Abandoned

Date

DEC 4 1940 19S. J. LEWIS Scout