

KANSAS

Form 51-5M-7-40-Palace

Barton

Section 3 Township 17 Range 11-W

Well No. #6 Radenberg

Company Shell

Kraft Pool

NORTH

WEST

EAST

SOUTH

	0					

Sec. 3 Twp. 17 R. 11-W

Well No. #6 Radenberg Farm

Shell Company

(Kraft)


_____ Ft. from N. Line

380 Ft. from S. Line

_____ Ft. from E. Line

1036 Ft. from W. Line

Elev. 1883

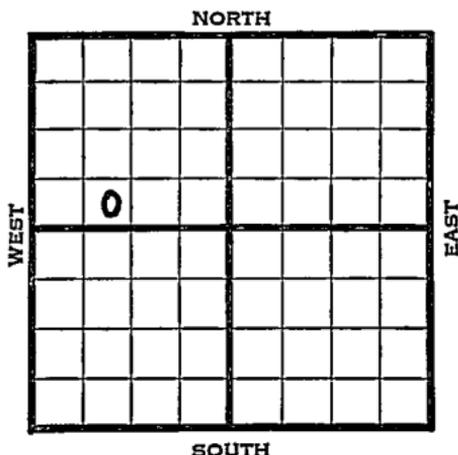

1941	REPORT
3/26	8" - 348'
	Drlg. 1366'
4/2	Topeka 2673' Drlg. 2854'
4/10	Lans. 3031' Sooy 3289'
	Arb. 3298-3300' T.D. 4" - 3299'
	RUST.
4/18	T.D. 3324' Swab 196 bbls. oil
	4 hours. 700' off bottom.
4/23	Arb. 3298'
	4" - 3299'
	T.D. 3324'
	Depthograph potential 2164 bbls.
	43.6 Gravity
	COMPLETED

Map No. 55 Sec. 3 Twp. 17 R. 11W

Well No. 6 Radenberg

Shell

Company

~~FIRST REPORT~~

Contractor

SECTION PLAT

SE SW NW

_____ Ft. from N. Line

380 Ft. from S. Line

_____ Ft. from E. Line

1036 Ft. from W. Line

KRAFT POOL

Location _____

Rig up _____

Drilling and Remarks:

8" - 348

Drilling 1366

RECORD

Cased _____ in., _____ ft.

Sand _____

Gas _____

Oil _____

Total Depth _____

PRODUCTION

1st 24 hrs. Nat. _____

1st 24 hrs. after shot _____

Gas _____ Cu. Ft.

Dry Hole _____

Abandoned _____

Date

MAR 26 1941

19

S. J. LEWIS Scout

