


Section 3 Township 17 Range 11 W

Well No. # 9 Frees

Company Derby Oil

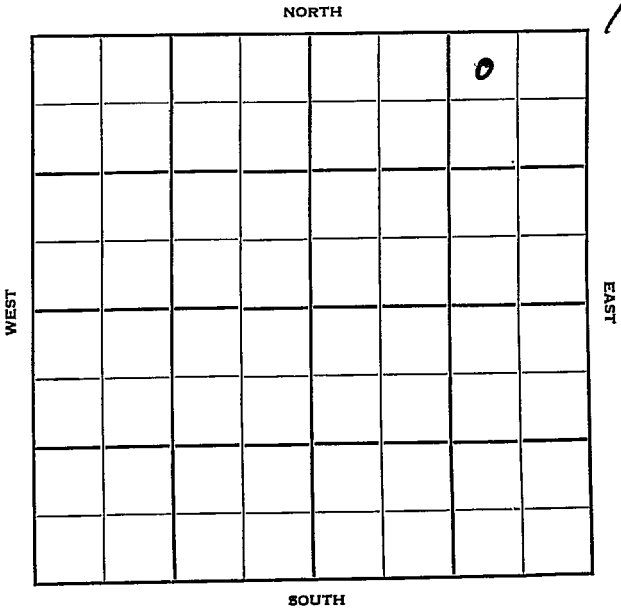

Sec. 3 Twp. 17 R. 11W

Well No. #9 Frees Farm

Derby Oil Company

Peel Bros. Contractor


330 Ft. from N. Line

\_\_\_\_\_ Ft. from S. Line

990 Ft. from E. Line

\_\_\_\_\_ Ft. from W. Line

NW NE NE

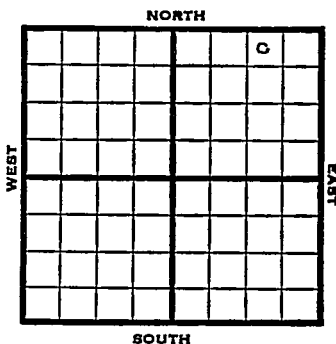

1952

Elev. 1943' REPORT

11/18

Spud 11-16-52  
8" @ 318'

Drlg. 1940'

11/27

Heeb 2984, Br Li 3084, Lans  
3100', Arb 3398,  
DST 3395-3408

12/3

Spud 11-16-52

D&A

TD 3408'

8" @ 318

Heeb. 2984, Br. lime 3084,

Lans 3100, Arb. 3401

DST 3401-08, opn 1 hr., rec.

560' sul. wtr., 1000#

TD 3408

D&A

**ABANDONED**



