


Ellis

KANSAS

SECTION 32 TOWNSHIP 12S RANGE 20W

WELL NO. #1 Huber

COMPANY Houston, Chandler & Simpson

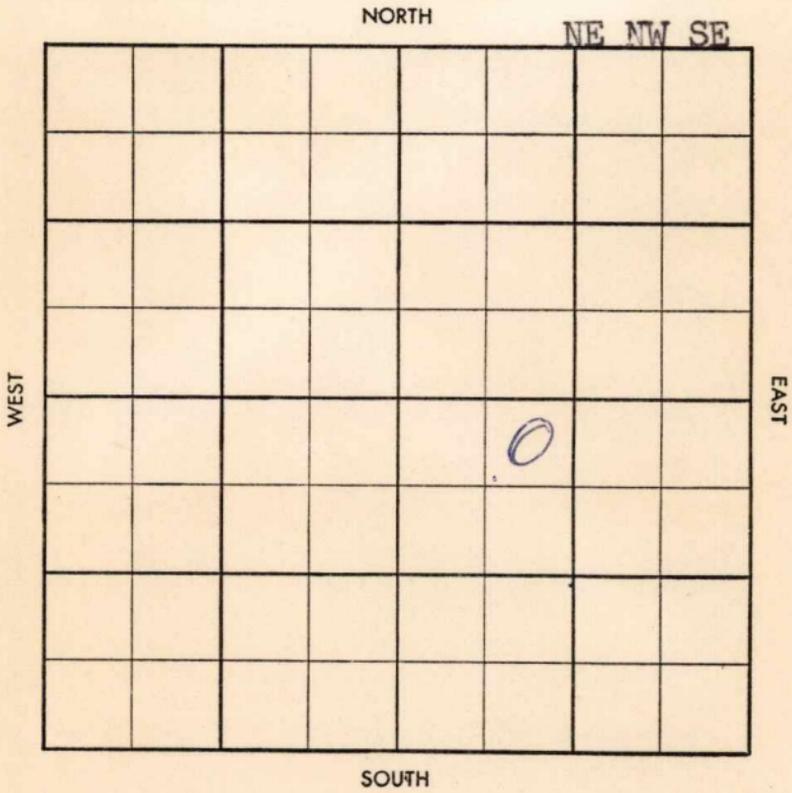

~~Ellis Pool~~

County Ellis Elev. _____
 Sec. 32 Twp. 12 Rge. 20W
 Company Houston, Chandler & Simpson
 Farm Name Huber No. 1

TOPS	DEPTH	LOG	DATUM
Anh.			
Tp.			
H.			
Tr.			
Dg.			
B.L.			
L.			
K.C.			
B.K.C.			
Ce.			
C.			
M.			
M.			
K.			
Mz.			
Mq.			
V.			
S.			
S.			
A.			
R.			
Pf.			
G.			
T.D.			

Loc. in Sec. NE NW SE

Geol. _____
 Contr. _____
 Pool Ellis



Date Comm. _____
Location

Co.
Lse.
No.
Sec.
T.
R.

Twp. ~~X~~ Pool ~~Ellis~~

Co. ~~X~~ Facet ~~X~~

S-513-B

County Ellis Elev. 2173 DF 2176 RE
Sec. 32 Twp. 12 Rge. 20W
Company Houston, Chandler & Simpson
Farm Name Huber No. 1

TOPS	DEPTH	LOG	DATUM
Anh.	<u>1530</u>		
Tp.			
H.			
Tr.			
Dg.			
B.L.			
L.	<u>3479</u>		
K.C.			
B.K.C.	<u>3728</u>		
Ce.			
C.	<u>3815</u>		
M.			
M.			
K.			
Mz.			
Mq.			
V.			
S.			
S.			
A.	<u>3845</u>		
R.			
Pf.			
G.			
T.D.	<u>3875</u>		

Loc. in Sec. NE NW SE
Geol. _____
Contr. _____
Pool Ellis

ABANDONED
APR 9 '58

Date Comm. 3-26-58
Location MIR APR 2 58 8"
346 Ø 3416 APR 9 '58 DST 3845
-51 op 1hr 20'm BMPO DST
3845-57 op 1hr 25'm BMPO
no log

DSA

Co.
No.
Sec.
T.
R.