

KANSAS

FORM 51 5M 4-41 PETROL

Barton


Section 3 Township 17 Range 11-W

Well No. #10 Disque

Company Texas

NORTH Kraft Pool

12

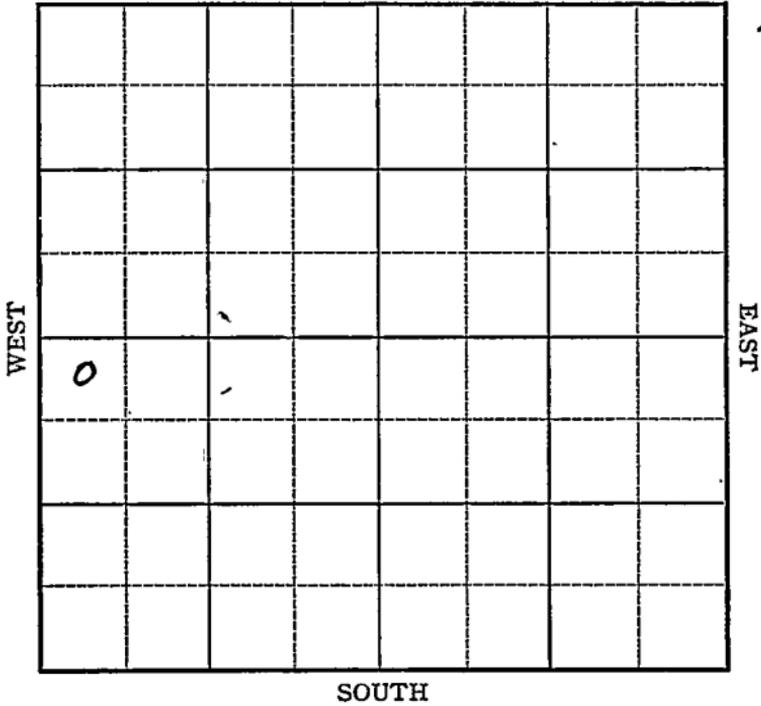

Sec. 3 Twp. 17 R. 11-W

Well No. #10 Disque Farm

Texas Company

(Kraft)


330 Ft. from N. Line

_____ Ft. from S. Line

_____ Ft. from E. Line

330 Ft. from W. Line

Elev. 1879

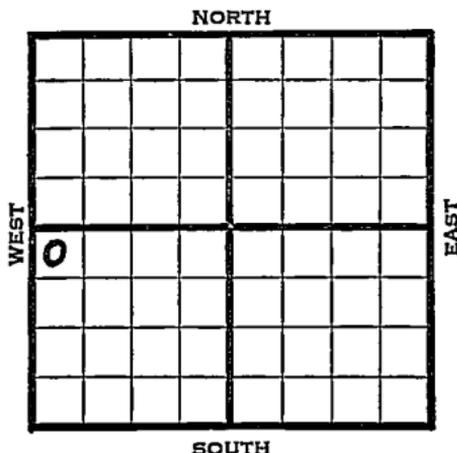

1941

REPORT

4/23

Derrick.

5/1

10" - 255' Drlg. 2765'

5/8

Arb. 3328' 7" - 3328'

T.D. 3336 1/2' Swab 34 bbls. in 8 hours.

5/15

T.D. 3341' Swab 29 bbls. in 3 hours.

5/22

" " "

5/28

" " "

6/4

Arb. 3328'

7" - 3328'

T.D. 3341'

Potential 48 bbls., pump.

43.6 Gravity

COMPLETED

Map No. 85 Sec. 3 Twp. 17 R. 11WWell No. 10 Disque

Texas

Company

~~FIRST REPORT~~

Contractor

SECTION PLAT

NW SW

330 Ft. from N. Line

_____ Ft. from S. Line

_____ Ft. from E. Line

330 Ft. from W. Line

o			

KRAFT POOL

Location _____

Rig up _____

Drilling and Remarks:

Derrick

RECORD

Cased _____ in., _____ ft.

Sand _____

Gas _____

Oil _____

Total Depth _____

PRODUCTION

1st 24 hrs. Nat. _____

1st 24 hrs. after shot _____

Gas _____ Cu. Ft.

Dry Hole _____

Abandoned _____

Date

APR 23 1941

19

S. J. LEWIS Scout

Map No. _____ Sec. 3 Twp. 17 ^{2R} 11WWell No. 10 DisqueTexas

Company _____

COMPLETED

Contractor _____

NW SW

330 Ft. from N. Line

_____ Ft. from S. Line

_____ Ft. from E. Line

330 Ft. from W. Line

KRAFT POOL

SECTION PLAT

a			

Location _____

Rig up _____

Drilling and Remarks:

*Cell 3328**7" @ 3328**Pump 45 P.Y.**43 6/9*

RECORD

Cased _____ in., _____ ft.

Sand _____

Gas _____

Oil _____

Total Depth 3341

PRODUCTION

1st 24 hrs. - Nat. _____

1st 24 hrs. after shot _____

Gas _____ Cu. Ft.

Dry Hole _____

Abandoned _____

Date

JUN 4 1941S. J. LEWIS Scout