


Barton **KANSAS**

Section 3 Township 17 Range 11-W

Well No. 13 Frees

Company Derby

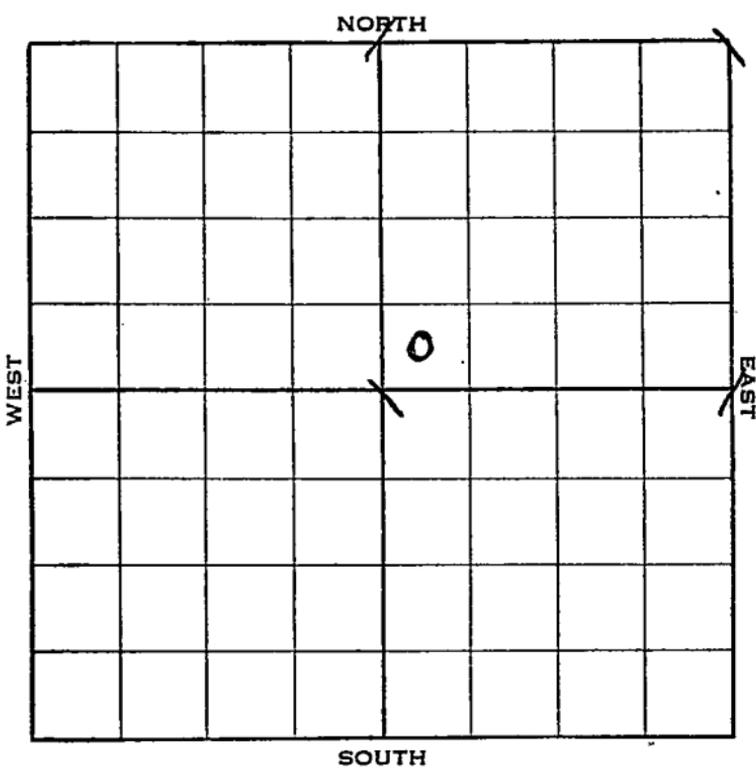

**KANSAS**

**Barton**

Sec. 3 Twp. 17 R. 11-W

Well No. #13-Frees Farm \_\_\_\_\_

Derby Company \_\_\_\_\_


\_\_\_\_\_ Ft. from N. Line

330 Ft. from S. Line

\_\_\_\_\_ Ft. from E. Line

330 Ft. from W. Line

Elev. 1914

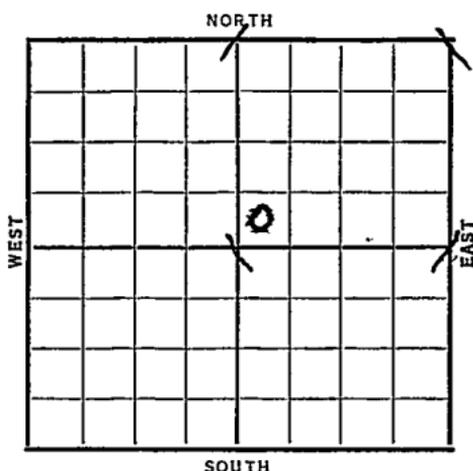

Date	REPORT
1938	
3/2	B. R. R.
3/11	"
3/18	13" @ 317'. WOG.
3/25	Drig. 2747'.
4/1	Lans. 3055'. Arb. 3320'.
	T.D. 3330'. Sat. Core.
	7" @ 3320'. RUST.
4/8	T.D. 3333'. 3000' oil in 4 hrs.
4/13	7" @ 3320'.
	Arb. 3320'.
	T.D. 3333'.
	Potential 2031 bbls., Nat'l.
	<b>COMPLETED</b>

Barton KANSAS

Map No. \_\_\_\_\_ Sec. 3 Twp. 17 R. 11W

Well No. 13 Frees

Derby Company

Contractor

### FIRST REPORT

SW NE


\_\_\_\_\_ Ft. from N. Line

330 Ft. from S. Line

\_\_\_\_\_ Ft. from E. Line

330 Ft. from W. Line

### SECTION PLAT

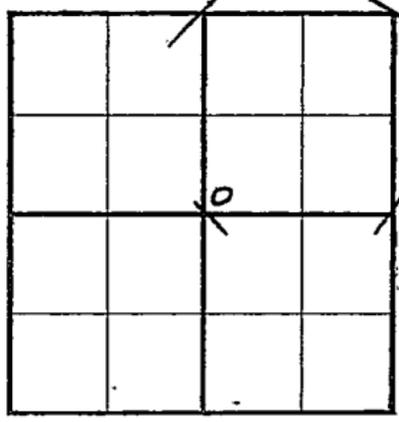

Location \_\_\_\_\_

Rig up \_\_\_\_\_

Drilling and Remarks:

**BRR**

### RECORD

Cased \_\_\_\_\_ in., \_\_\_\_\_ ft.

Sand \_\_\_\_\_

Gas \_\_\_\_\_

Oil \_\_\_\_\_

Total Depth \_\_\_\_\_

### PRODUCTION

1st 24 hrs. Nat \_\_\_\_\_

1st 24 hrs. after shot \_\_\_\_\_

Gas \_\_\_\_\_ Cu. Ft.

Dry Hole \_\_\_\_\_

Abandoned \_\_\_\_\_

Date

MAR 2 - 1938 19

H. D. Hatfield Scout

Map No. 55Sec. 3Twp. 17R. 11WWell No. 13 FreesDerby

Company

Contractor

**COMPLETED**

SW NE

\_\_\_\_\_ Ft. from N. Line

330 Ft. from S. Line

\_\_\_\_\_ Ft. from E. Line

330 Ft. from W. Line

## SECTION PLAT

		0	

Location \_\_\_\_\_

Rig up \_\_\_\_\_

Drilling and Remarks:

Pot. 20 31

NAT

## RECORD

Cased 7 in., 3320 ft.Sand Arb 3320

Gas \_\_\_\_\_

Oil \_\_\_\_\_

Total Depth 3333

## PRODUCTION

1st 24 hrs. Nat. \_\_\_\_\_

1st 24 hrs. after shot \_\_\_\_\_

Gas \_\_\_\_\_ Cu. Ft.

Dry Hole \_\_\_\_\_

Abandoned \_\_\_\_\_

Date

APR 13 1938

19

H. D. Hatfield

Scout