


Section 4 Township 17 Range 11-W

Well No. #1 Riemann

Company Magnolia

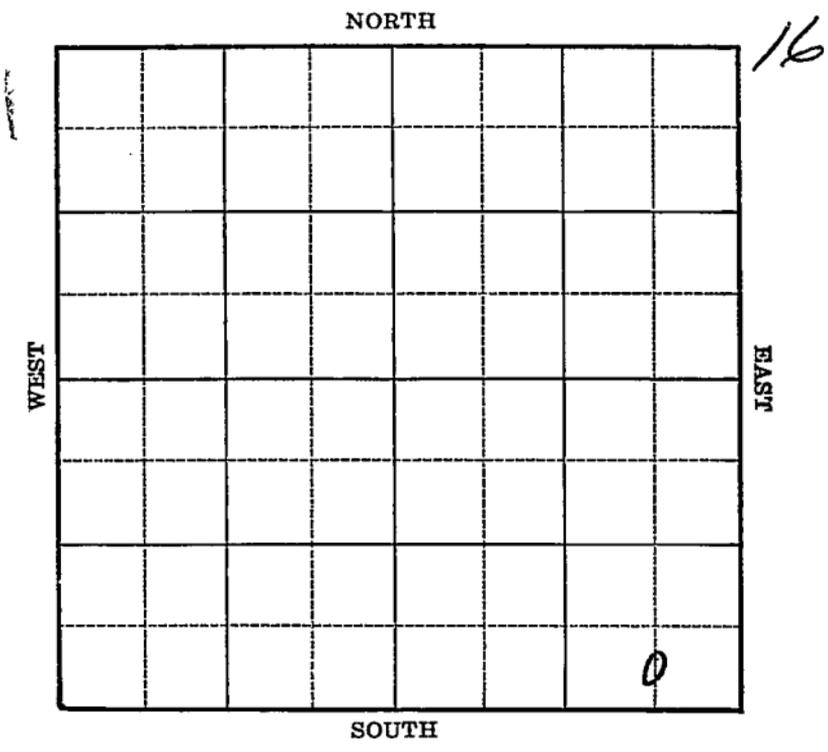

Map No. 55 Sec. 4 Twp. 17 R. 11W

Well No. 1 Riemann

Magnolia Company

Contractor

COMPLETED

SECTION PLAT

C S L SE SE

Ft. from N. Line

330 Ft. from S. Line

660 Ft. from E. Line

Ft. from W. Line

KRAFT POOL

Location _____

Rig up _____

Drilling and Remarks:

Ce 43289

5" @ 3289

Ech Rd 4358

Max 3000

43.6 Gr.

RECORD

Cased _____ in., _____ ft.

Sand _____

Gas _____

Oil _____

Total Depth 3297

PRODUCTION

1st 24 hrs. Nat. _____

1st 24 hrs. after shot _____

Gas _____ Cu. Ft.

Dry Hole _____

Abandoned _____

Date

JAN 22 1941 19

S. J. LEWIS Scout