

# KANSAS

Form 51-5M-7-40-Palace

Barton


Section 4 Township 17 Range 11-W

Well No. #2 Riemann

Company Magnolia

NORTH Kraft Pool

14

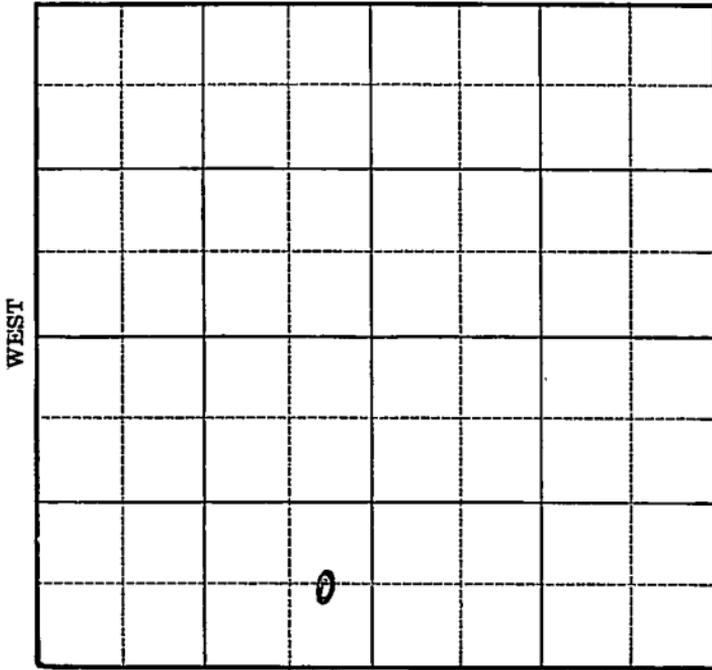

SOUTH



Map No. 55 Sec. 4 Twp. 17 R. 11WWell No. 2 Riemann

Magnolia

Company

Contractor

~~FIRST REPORT~~

## SECTION PLAT

C E L S E S W

         Ft. from N. Line660 Ft. from S. Line330 Ft. from E. Line         Ft. from W. Line


KRAFT POOL

Location                                 Rig up                                 

Drilling and Remarks:

S.H.

## RECORD

Cased          in.,          ft.Sand                                 Gas                                 Oil                                 Total Depth                         

## PRODUCTION

1st 24 hrs. Nat.                         1st 24 hrs. after shot                         Gas                                  Cu. Ft.Dry Hole                                 Abandoned                                 

Date

MAR 12 1941 19S. J. LEWIS Scout

Map No. 55 Sec. 4 Twp. 17 R. 11WWell No. 2 RiemannMagnolia CompanyABANDONED Contractor

## SECTION PLAT

C E L S E SW

\_\_\_\_\_ Ft. from N. Line

660 Ft. from S. Line330 Ft. from E. Line

\_\_\_\_\_ Ft. from W. Line


KRAFT POOL

Location \_\_\_\_\_

Rig up \_\_\_\_\_

Drilling and Remarks:

*Cr 83358**No show*

## RECORD

Cased \_\_\_\_\_ in., \_\_\_\_\_ ft.

Sand \_\_\_\_\_

Gas \_\_\_\_\_

Oil \_\_\_\_\_

Total Depth 2271

## PRODUCTION

1st 24 hrs. Nat. \_\_\_\_\_

1st 24 hrs. after shot \_\_\_\_\_

Gas \_\_\_\_\_ Cu. Ft.

Dry Hole \_\_\_\_\_

Abandoned \_\_\_\_\_

Date

APR 2 1941 19

S. J. LEWIS Scout