


Section 32 Township _____ Range 20 W

Well No. # 1 Huber "B"

Company ~~XXX~~ Doley Oil

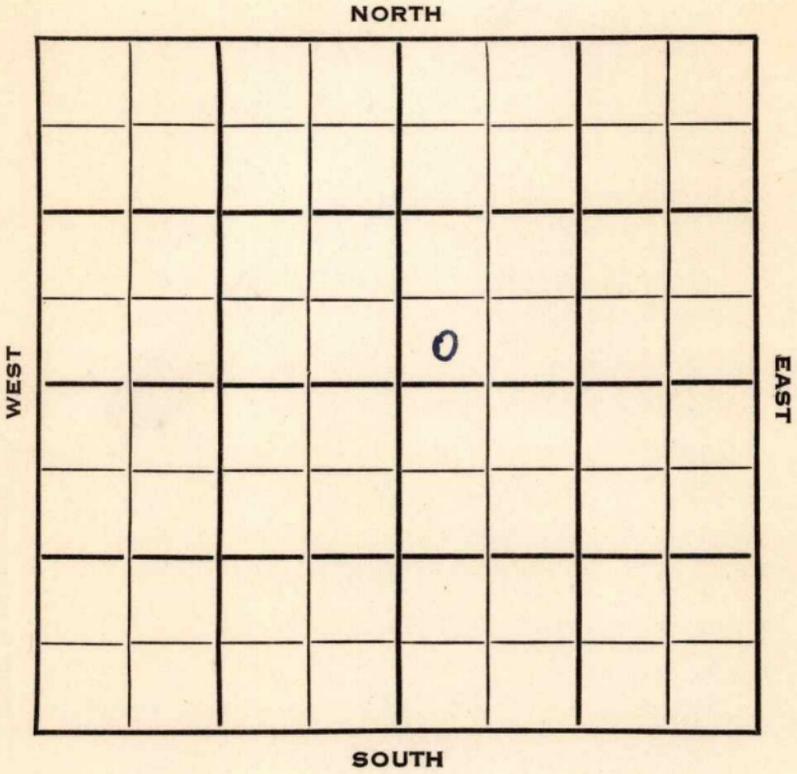

Sec. 32 Twp. 12 R. 20W

Well No. #1 Huber "B" Farm _____

Doley Oil Company

Glenn Nye Contractor
Wildcat.


_____ Ft. from N. Line

330 Ft. from S. Line

_____ Ft. from E. Line

330 Ft. from W. Line

SW SW NE
Lion * DHM

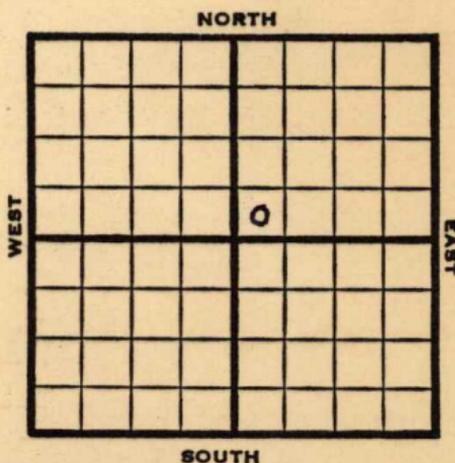

1953 **Elev. 2199'** REPORT

- 6/10 Spud 6-3-53
8" @ 155'
Anhy 1549', Top. 3222
Drlg 3410'
- 6/24 **Tor 3475 Lans 3494**
DST 3519-50, 1 hr 170' SGCM & W
1100# 15" **Cong 3836 Arb 3853**
DST 3855-64, 1 hr, 30' V hly OCM
750# RTD 3864 5" @ 3855
- 7/1 DD 3865, 750A
B/12 goph 8 hrs., 24/3853-59,
elec log 500A
S/1/2 BOPH
- 7/8 N.R.
- 7/22 NR
- 7/29 "
- 8/5 "
- 9/9 "
- 9/16 "
- 9/23 "
- 10/7 "
- 10/14 "

JVER

1953

10/21

Spud 6-3-53

Oil Well

TD 3865

8" @ 155

Anhy 1549, Top 3222, Tor 3475,

Lans 3494

DST 3519-50, opn 1 hr., rec. 170'

sgcm & w tr., 1100#

Cong 3836, Arb. 3853

DST 3855-64, opn 1 hr., rec. 30'

vhocm, 750#

TD 3864

5" @ 3859

DD 3865 750A

B/12 goph 8 hrs., 24/3853-59, 500A

S/1/2 boph

B/19 goph

Hydro.

P/30 bopd

Comp. 25 bopd 6% wtr.

COMPLETED

