


Barton

KANSAS

Section 4 Township 17 Range 11-W

Well No. #2 Grossardt

Company Black-Marshall

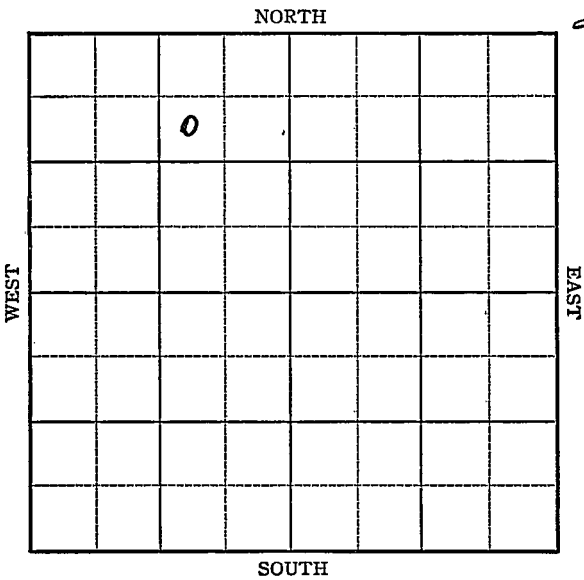

Sec. 4 Twp. 17 R. 11-W

Well No. #2 Grossardt Farm

Black-Marshall Company

(Kraft)


990 Ft. from N. Line

 Ft. from S. Line

990 Ft. from E. Line

 Ft. from W. Line

Elev. 1864

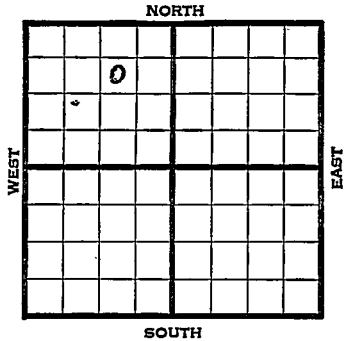

1941	REPORT
11/25	Rig.
12/4	Cable rig.
12/11	Spud.
12/18	20" @ 251 12" @ 375
	Anhy 695
	10" @ 704 Drlg. 950
12/24	Drlg. 1610"
12/31	2373' run 8".
1942	
1/8	8" - 2050' 24000 U.R. 8".
1/15	Drlg. 2875'
1/22	Lans. 3005' S.S.O. 3240-45'
	Drlg. 3260'
1/29	Arb. 3299-3309' T.D. 5" - 3302'
	RUST.
2/5	"
2/12	T.D. 3314' 1000 acid.
	Pump 24 oil per hour, 16 hours.
2/19	2000 acid.
	OVER

1942
2/25

Arb. 3299'

5" - 3302'

T.D. 3314'

3000 acid.

Echometer potential 2730 bbls.

43.6 Gravity

COMPLETED

Map No. K 55 Sec. 4 Twp. 17 R. 11W

Well No. 2 Grossardt

Black-Marshall Company

FIRST REPORT Contractor

SW NE NW

SECTION PLAT

990 Ft. from N. Line

_____ Ft. from S. Line

990 Ft. from E. Line

_____ Ft. from W. Line

	o		

KRAFT POOL

RECORD

Location _____

Cased _____ in., _____ ft.

Rig up _____

Sand _____

Drilling and Remarks:

Gas _____

Oil _____

Rig

Total Depth _____

PRODUCTION

1st 24 hrs. Nat. _____

1st 24 hrs. after shot _____

Gas _____ Cu. Ft.

Dry Hole _____

Abandoned _____

Date

NOV 25 1941

19

S. J. LEWIS Scout

Barton

Map No. 55 Sec. 4 Twp. 17 R. 11WWell No. 2 GrossardtBlack-Marshall

Company

COMPLETED

Contractor

SW NE NW

SECTION PLAT

990 Ft. from N. Line

_____ Ft. from S. Line

990 Ft. from E. Line

_____ Ft. from W. Line

	o		

KRAFT PRUSA POOL

Location _____

Rig up _____

Drilling and Remarks:

*Cr. 3299**3" @ 3302.**3000 acid**Ech. P. 2730**43 6 gr*

RECORD

Cased _____ in., _____ ft.

Sand _____

Gas _____

Oil _____

Total Depth 3314

PRODUCTION

1st 24 hrs. Nat. _____

1st 24 hrs. after shot _____

Gas _____ Cu. Ft.

Dry Hole _____

Abandoned _____

Date

FEB 25 1942

19

S. J. LEWIS

Scout