


32

Section 22 Township 12 Range 20W

Well No. 1 Shubert

Company Darby Oil

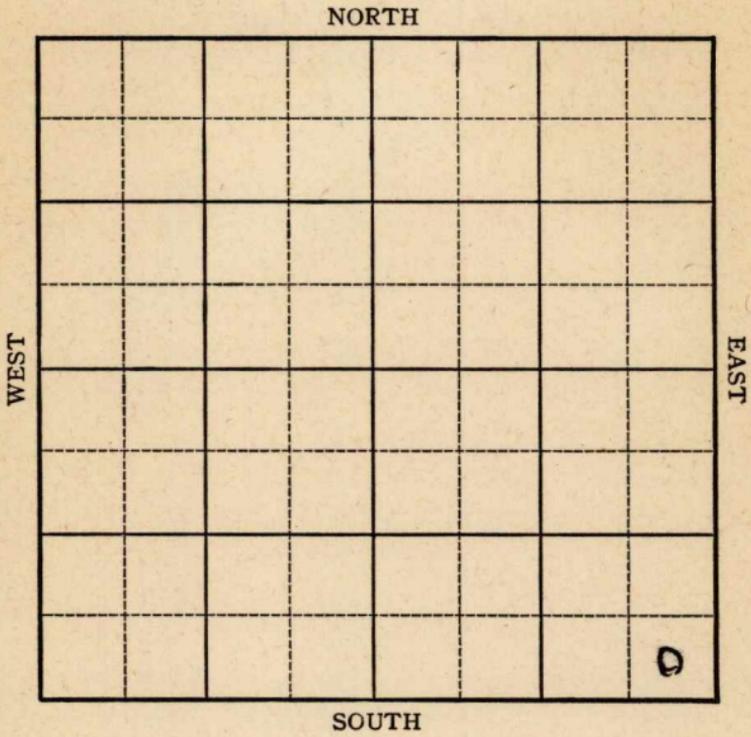

KANSAS

Ellis County


Sec. 32 Twp. 12 R. 20W

Well No. #1 Shubert Farm

Darby Oil Company

Ellis

NORTH

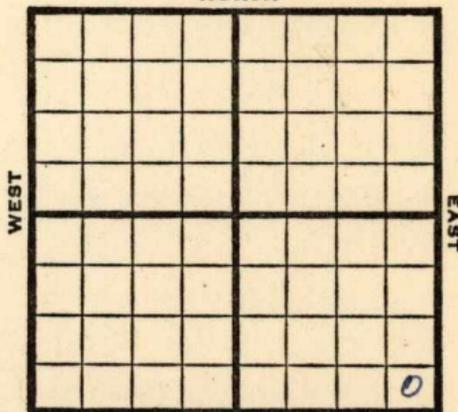

Ft. from N. Line

330 Ft. from S. Line

330 Ft. from E. Line

Ft. from W. Line

SE/c

SOUTH

1946

Elev. 2137

REPORT

5/22 Location

5/29 **Anhy. 1505**

Drlg. 2325'

6/5 Drlg. 3305'

6/12 **Lans 3405**

Arb. 3812

TD 3826

ABANDONED

70

Kansas Pool Name Ellis

Map No. KANSAS Sec. 22 Twp. 12 R. 20W

Well No. 1 Shubert

Darby Oil Company

FIRST REPORT

Contractor

SE/C


SECTION PLAT

 Ft. from N. Line

330 Ft. from S. Line

330 Ft. from E. Line

 Ft. from W. Line

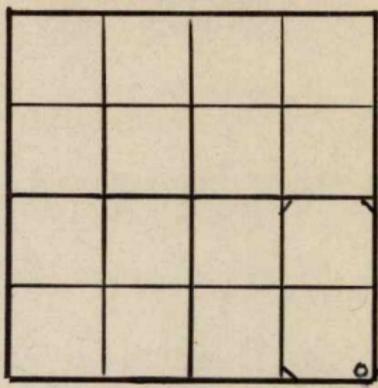

Ellis County

Location ✓

Rig up

Drilling and Remarks:

RECORD

Cased in., ft.

Sand

Gas

Oil

Total Depth

PRODUCTION

1st 24 hrs. Nat.

1st 24 hrs. after shot

Gas Cu. Ft.

Dry Hole

Abandoned

Date

MAY 22 1946 19

S. J. LEWIS Scout

check Sec
Advise
Sam



Insc. Small Maps	<i>[initials]</i>
Cards	<i>Dorethy</i>
Tracing	<i>Fi</i>
France Map	<i>[initials]</i>
Scarborough Map	<i>[initials]</i>
Pierce Map	<i>[initials]</i>
Geological Dept.	
Pierce Plat Book	

This is o.k.

Sincerely
F