

Section 4 Township 17 Range 11W

Well No. 3 Riemann

Company Ohio Oil

Kraft-Prusa Pool
NORTH

WEST	0						

12

EAST

SOUTH

KANSAS

Barton



Sec. 4 - Twp. 17 R. 11W

Well No. #3 Riemann Farm

Ohio Oil Company


Kraft-Prusa Pool

330' Ft. from N. Line

_____ Ft. from S. Line

_____ Ft. from E. Line

330' Ft. from W. Line

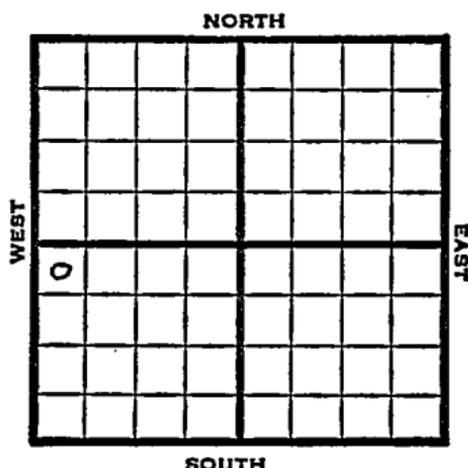

NW SW

1948	Elev. 1866' REPORT
11/23	Location
11/30	"
12/8	Surface hole
12/15	10" @ 332'
12/22	Drlg 2525'
	Lansing 3014'
	Arb. 3319-22'
	TD 3322'
	7" @ 3319'
12/29	"
1/5	Drlg. 3329'
	1000 acid
1/12	TD 3333
1/19	Swb 25 bbls oil 8 hrs.
1/26	"
2/2	"
2/9	"
2/16	Arb 3319'
	7" @ 3319'
	Pump 34 oil Pot.
	TD 3333'
	Gr. 42°
	COMPLETED

Map No. _____ Sec. 4 Twp. 17 R. 11W

Well No. 3 Riemann

Ohio Oil Company

FIRST REPORT

Contractor _____

NW SW

SECTION PLAT

330 Ft. from N. Line

_____ Ft. from S. Line

_____ Ft. from E. Line

330 Ft. from W. Line

o			

Barton County

Location X

Rig up _____

Drilling and Remarks:

RECORD

Cased _____ in., _____ ft.

Sand _____

Gas _____

Oil _____

Total Depth _____

PRODUCTION

1st 24 hrs. Nat. _____

1st 24 hrs. after shot _____

Gas _____ Cu. Ft.

Dry Hole _____

Abandoned _____

Date

NOV 23 1948 19

S. J. LEWIS Scout

Map No. K55 Sec. 4 Twp. 17 R. 11W

Well No. 3 Rieman

Ohio Oil Company

COMPLETE

Contractor

NW SW

E. 1866

SECTION PLAT

330 Ft. from N. Line

_____ Ft. from S. Line

_____ Ft. from E. Line

330 Ft. from W. Line

o			

Barton County

Location _____

Rig up _____

Drilling and Remarks:

Per 3319

7" C 3319

Prod 34 oil Prod

42 1/2

RECORD

Cased _____ in., _____ ft.

Sand _____

Gas _____

Oil _____

Total Depth 3333

PRODUCTION

1st 24 hrs. Nat. _____

1st 24 hrs. after shot _____

Gas _____ Cu. Ft.

Dry Hole _____

Abandoned _____

Date

FEB 16 1949 19

S. J. LEWIS

Scout