


Barton

Section 4 Township 17 Range 11-W

Well No. #3 Riemann

Company Magnolia

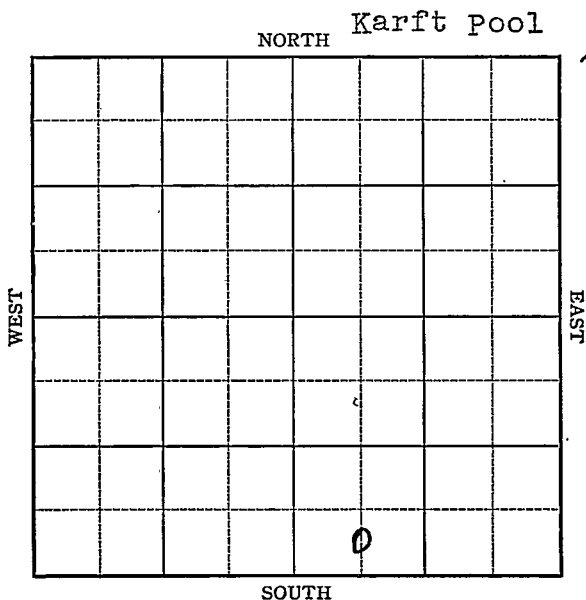

KANSAS


Barton

Sec. 4 Twp. 17 R. 11-WWell No. #3 Riemann FarmMagnolia Company

(Kraft)

 Ft. from N. Line330 Ft. from S. Line Ft. from E. Line660 Ft. from W. Line

Elev. 1860

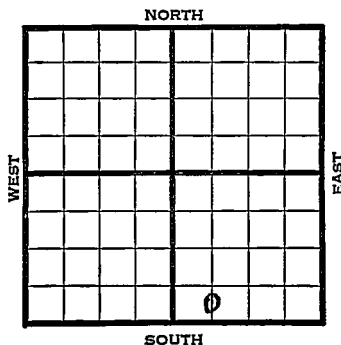

REPORT

~~1941~~

5/14 10" - 286' WOC.

5/22 Drlg. 2915'

5/28 Lans. 3010' Arb. 3319'

5" - 3319' T.D. 3327' RUST.

6/5 15 acid. No help.

Shot 5 qts. 3322-27' C.O.

6/11 Arb. 3319'

5" - 3319'

T.D. 3327'

5 qts. 3322-27'

3500 acid.

Pump 15 oil & 224 water.

ABANDONED

Map No. 55 Sec. 4 Twp. 17 R. 11WWell No. 3 RiemannMagnolia

Company

FIRST REPORT

Contractor

C S L SW SE

SECTION PLAT

 Ft. from N. Line330 Ft. from S. Line Ft. from E. Line660 Ft. from W. Line

KRAFT POOL

Location Rig up

Drilling and Remarks:

10" - 286WOC

RECORD

Cased in., ft.Sand Gas Oil Total Depth

PRODUCTION

1st 24 hrs. Nat. 1st 24 hrs. after shot Gas Cu. Ft.Dry Hole Abandoned

Date

MAY 14 1941S. J. LEWIS Scout

Map No. 55 Sec. 4 Twp. 17 R. 11WWell No. 3 RiemannMagnolia

Company

ABANDONED

Contractor

SECTION PLAT

C S L SW SE

Ft. from N. Line

330 Ft. from S. Line

Ft. from E. Line

660 Ft. from W. Line

KRAFT POOL

Location _____

Rig up _____

Drilling and Remarks:

Ar 833195" 103319598 3322-273500 acidPump 15 oil 224 1/2

RECORD

Cased _____ in., _____ ft.

Sand _____

Gas _____

Oil _____

Total Depth 3327

PRODUCTION

1st 24 hrs. Nat. _____

1st 24 hrs. after shot _____

Gas _____ Cu. Ft.

Dry Hole _____

Abandoned _____

Date

JUN 1 1 1941S. J. LEWIS Scout