


Section 32 Township 12 Range 20W

Well No. ¹⁶⁵ONE 2 #1 Shubert

Company Lion Oil

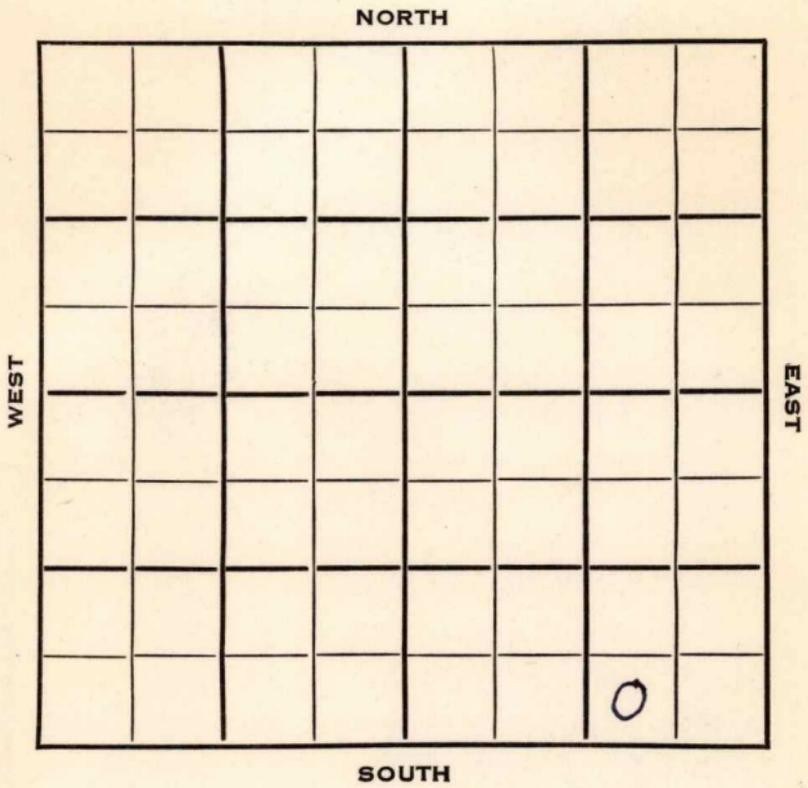

Ellis

FORM 282-B

KANSAS ✓

Sec. 32 Twp. 12 R. 20W

Well No. 1665 DNL-2 #1 Shubert Farm

Lion Oil Company

Garvey Contractor


Ellis Pool ext.

_____ Ft. from N. Line

330 Ft. from S. Line

990 Ft. from E. Line

_____ Ft. from W. Line

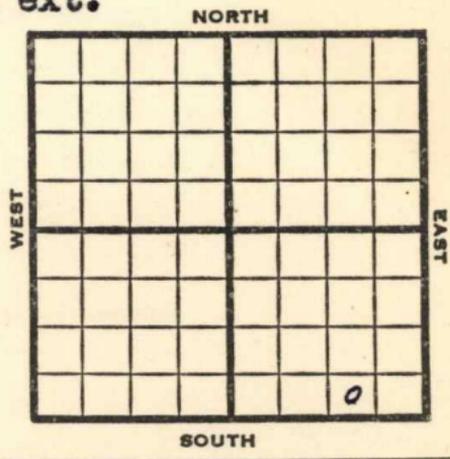

SW SE SE

1953 **Elev. 2157'** REPORT

8/19 R U R

8/26 8" @ 205' w/135 sks
Heeb 3422, Lans 3460
DST 3505-60 1 hr, 60' MCW 1200#
Drlg 3560'

9/2 Spud 8-18-53
D&A
TD 3858
8" @ 205'
Top 3188, Heeb 3422, Lans 3460
DST 3505-60, opn 1 hr., rec. 60' mcw 1200#
DST 3654-80, opn 1 hr., rec. 142' sw, 910#
Cong 3799, B KC 3708, Arb. 3847
TD 3858
D&A

ABANDONED

