

# KANSAS


FORM 51 5M 1-42 PETROL

Barton

Section 4 Township 17 Range 11-W

Well No. #4 Grossardt

Company Black & Marshall

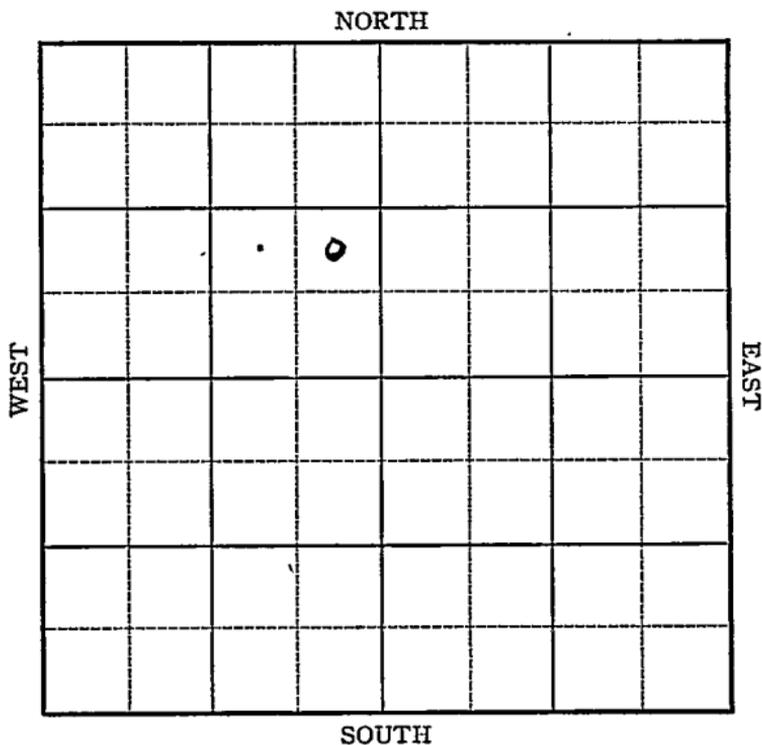

KANSAS

Sec. 4 Twp. 17 R. 11-W

Well No. #4 Grossardt Farm

Black & Marshall Company

Kraft Prusa


           Ft. from N. Line

990 Ft. from S. Line

330 Ft. from E. Line

           Ft. from W. Line

*Elev. 1868*

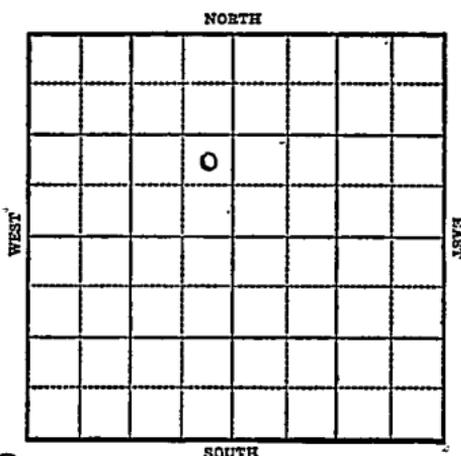

1943

R E P O R T

6/9 Cable rig

6/16 " "

6/23 " "

6/30 " "

7/7 12" @ 396  
Drlg. 650'

7/15 Anhy 718  
10" @ 721'  
Drlg. 1735'

7/21 8" @ 2056'  
Drlg. 2355'

7/28 8" @ 2443'  
Drlg. 2505'

8/4 6" @ 2995  
Lans 3005  
.D. 3020 UR 6"

8/11 6" @ 3159'  
Drlg. 3195'

8/18 Lans 3030  
BKC 3295  
Arb 3340  
T.D. 3343-400' oil 1½ hrs  
Run Csg.

8/25 5" @ 3335'

9/1 " " "

OVER

1943

9/8 1000 acid pump 13 oil per hr.

9/15

Arb 3340  
5" @ 3335  
1000 acid  
Pump 429 Pot.  
T.D. 3343  
Gravity 43.4

**COMPLETED**

Barton

Map No. 55 Sec. 4 Twp. 17 R. 11W

Well No. 4 Grossardt

Black & Marshall Company

FIRST REPORT Contractor

NE SE NW

SECTION PLAT

		o	

\_\_\_\_\_ Ft. from N. Line

990 Ft. from S. Line

330 Ft. from E. Line

\_\_\_\_\_ Ft. from W. Line

KRAFT PRUSA POOL

Location \_\_\_\_\_

Rig up \_\_\_\_\_

Drilling and Remarks:

Cable

RECORD

Cased \_\_\_\_\_ in., \_\_\_\_\_ ft.

Sand \_\_\_\_\_

Gas \_\_\_\_\_

Oil \_\_\_\_\_

Total Depth \_\_\_\_\_

PRODUCTION

1st 24 hrs. Nat. \_\_\_\_\_

1st 24 hrs. after shot \_\_\_\_\_

Gas \_\_\_\_\_ Cu. Ft.

Dry Hole \_\_\_\_\_

Abandoned \_\_\_\_\_

Date

JUN 9 1943 19

S. J. LEWIS Scout

**KANSAS**

Map No. 55 Sec. 4 Twp. 17 R. 11W

Well No. 4 Grossardt

Black & Marshall Company

**COMPLETED** Contractor

NE SE NW

**SECTION PLAT**

\_\_\_\_\_ Ft. from N. Line

990 Ft. from S. Line

330 Ft. from E. Line

\_\_\_\_\_ Ft. from W. Line

	o		

**Kraft-Prusa Pool**

Location \_\_\_\_\_

Rig up \_\_\_\_\_

Drilling and Remarks:

*Cr & 8340*  
*5-10-3335*  
*1000 acid*  
*Pump 429 Bx*  
*43 1/2 ft*

**RECORD**

Cased \_\_\_\_\_ in., \_\_\_\_\_ ft.

Sand \_\_\_\_\_

Gas \_\_\_\_\_

Oil \_\_\_\_\_

Total Depth 8340

**PRODUCTION**

1st 24 hrs. Nat. \_\_\_\_\_

1st 24 hrs. after shot \_\_\_\_\_

Gas \_\_\_\_\_ Cu. Ft.

Dry Hole \_\_\_\_\_

Abandoned \_\_\_\_\_

Date

SEP 15 1943 19

S. J. LEWIS Scout