

# KANSAS

FORM 51 5M 10-41 PETROL


Barton

Section 4 Township 17 Range 11-W

Well No. #4 Riemann

Company Magnolia

Kraft Prusa Pool NORTH

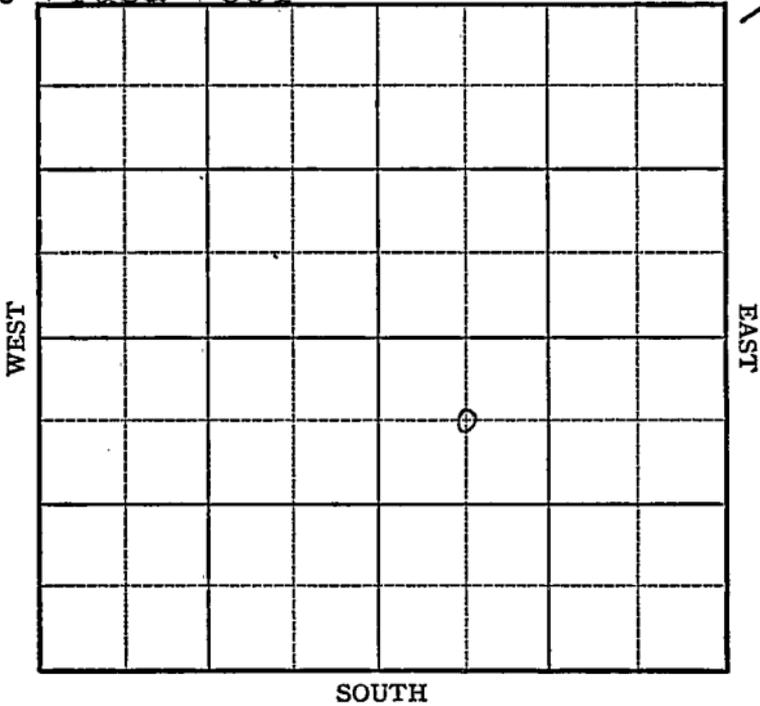

Sec. 4 Twp. 17 R. 11-W

Well No. #4 Riemann Farm

Magnolia Company


(Kraft Prusa Pool)

660 Ft. from N. Line

\_\_\_\_\_ Ft. from S. Line

\_\_\_\_\_ Ft. from E. Line

660 Ft. from W. Line

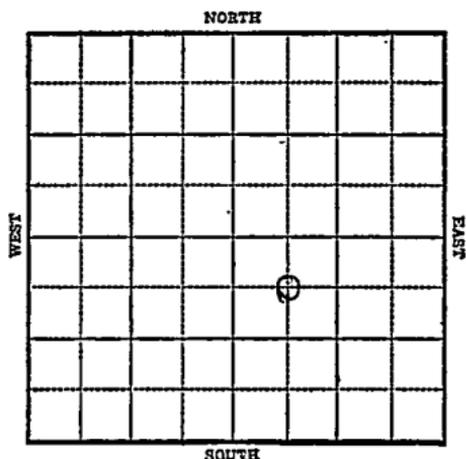

R E P O R T

1942

10/7 10" - 279'  
Waiting on cement.

10/14 Drlg. 2535'

10/21 Arb 3283-5" @ 3284 Rust

10/28 Arb. 3283  
5" - 3284'  
1000 acid  
T.D. 3291  
Depth Pot. 3723  
Max. 3000  
Gravity 43.6

**COMPLETED**

Map No. 55 Sec. 4 Barton Twp. 17 R. 11W

Well No. 4 Riemann

Magnolia Company

**FIRST REPORT**

Contractor

C NW SE

**SECTION PLAT**

660 Ft. from N. Line

\_\_\_\_\_ Ft. from S. Line

\_\_\_\_\_ Ft. from E. Line

660 Ft. from W. Line

		o	

**KRAFT PRUSA POOL**

Location \_\_\_\_\_

Rig up \_\_\_\_\_

Drilling and Remarks:

10"-279'  
Waiting on  
Cement

**RECORD**

Cased \_\_\_\_\_ in., \_\_\_\_\_ ft.

Sand \_\_\_\_\_

Gas \_\_\_\_\_

Oil \_\_\_\_\_

Total Depth \_\_\_\_\_

**PRODUCTION**

1st 24 hrs. Nat. \_\_\_\_\_

1st 24 hrs. after shot \_\_\_\_\_

Gas \_\_\_\_\_ Cu. Ft.

Dry Hole \_\_\_\_\_

Abandoned \_\_\_\_\_

Date

OCT 7 1942 19

S. J. LEWIS Scout

Map No. 55 Sec. 4 Twp. 17 R. 11WWell No. 4 RiemannMagnolia CompanyCOMPLETED Contractor


C NW SE

SECTION PLAT

660 Ft. from N. Line

\_\_\_\_\_ Ft. from S. Line

\_\_\_\_\_ Ft. from E. Line

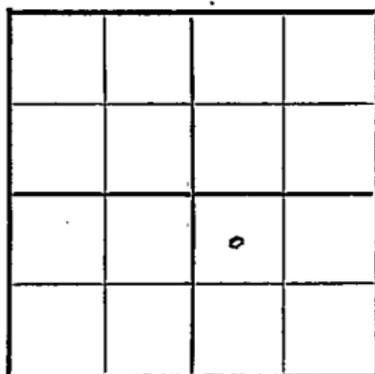660 Ft. from W. Line

KRAFT PRUSA POOL

Location \_\_\_\_\_

Rig up \_\_\_\_\_

Drilling and Remarks:

*Cor 43283*  
*5" @ 3284*  
*1000 acid*  
*Depth 43723*  
*Max 3000*  
*4364*

## RECORD

Cased \_\_\_\_\_ in., \_\_\_\_\_ ft.

Sand \_\_\_\_\_

Gas \_\_\_\_\_

Oil \_\_\_\_\_

Total Depth 3291

## PRODUCTION

1st 24 hrs. Nat. \_\_\_\_\_

1st 24 hrs. after shot \_\_\_\_\_

Gas \_\_\_\_\_ Cu. Ft.

Dry Hole \_\_\_\_\_

Abandoned \_\_\_\_\_

Date

OCT 28 1942 19S. J. LEWIS Scout