


Ellis

Section 28 Township 12 Range 16-WWell No. #1 RushCompany Cities Service Oil

Wildcat

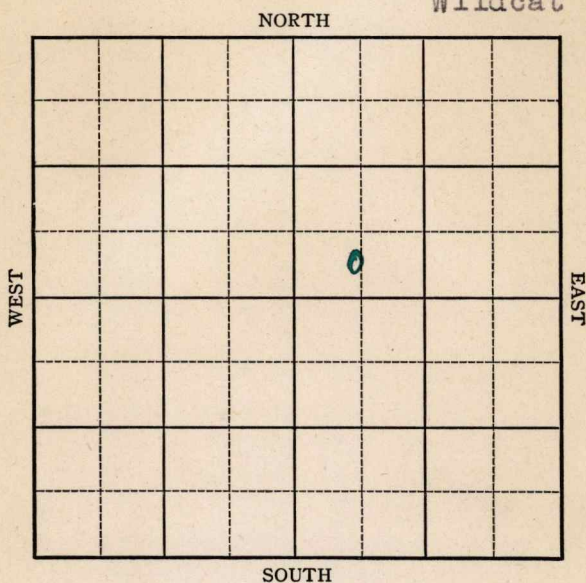


Sec. 28 Twp. 12 R. 16-WWell No. #1 Rush FarmCities Service Oil Company

(Wildcat)

 Ft. from N. Line300 Ft. from S. Line Ft. from E. Line650 Ft. from W. Line

Elev. 2106

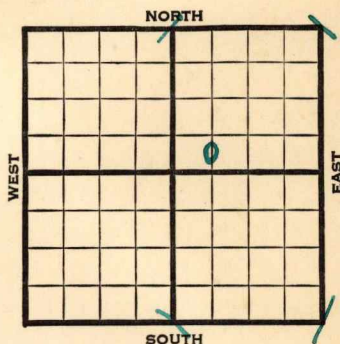

1941	REPORT
10/15	Rotary.
10/23	Rigging up.
10/30	10" - 342' Drlg. 3335'
11/6	Anhy. 1275' Lans. 3295'
	B.K.C. 3456' Arb. 3588'
	T.D. 3613' No show. 4" - 3490'
11/13	T.D. 3623' water. P.B. to 3607'
	WOC.
11/20	Shot 10 qts. 3596-3603' S.W.
	P.B. to 3500'
11/26	P.B. to 3449'
	12 shots 3442-47' 1000 acid.
12/4	P.B. to 3390' 12 shots 3377-81'
	Testing.
12/11	" " " " " "
12/17	Abb. 3588
	4" @ 3490
	Water
	TD 3623
	ABANDONED


KANSAS

Map No. KE 71 Sec. 28 Twp. 12 R. 16WWell No. 1 RushCities Service Oil CompanyFIRST REPORT Contractor

C SL SW NE

 Ft. from N. Line300 Ft. from S. Line Ft. from E. Line650 Ft. from W. Line

SECTION PLAT

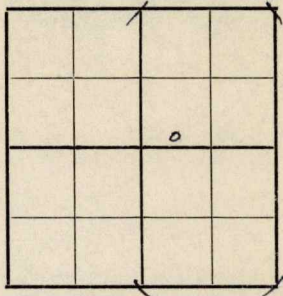

WILDCAT

Location Rig up

Drilling and Remarks:

Rotary

RECORD

Cased in., ft.Sand Gas Oil Total Depth

PRODUCTION

1st 24 hrs. Nat. 1st 24 hrs. after shot Gas Cu. Ft.Dry Hole Abandoned

Date

OCT 15 1941

19

S. J. LEWIS

Scout

Ellis

KANSAS

Map No. 71 Sec. 28 Twp. 12 R. 16WWell No. 1 RushCities Service Oil CompanyABANDONED Contractor

C SL SW NE

 Ft. from N. Line330 Ft. from S. Line Ft. from E. Line650 Ft. from W. Line

SECTION PLAT

		o	

WILDCAT

RECORD

Location Cased in., ft.Rig up Sand

Drilling and Remarks:

Gas On 8.3588Oil 4" @ 3490Total Depth 3623Water.

PRODUCTION

1st 24 hrs. Nat. 1st 24 hrs. after shot Gas Cu. Ft.Dry Hole Abandoned

Date

DEC 17 1941 19S. J. LEWIS Scout