

KANSAS


Barton county

FORM 51 5M 11-44 PETROL

Section 4 Township 17 Range 11W

Well No. #6, Grossheart

Company Balck-Marshall

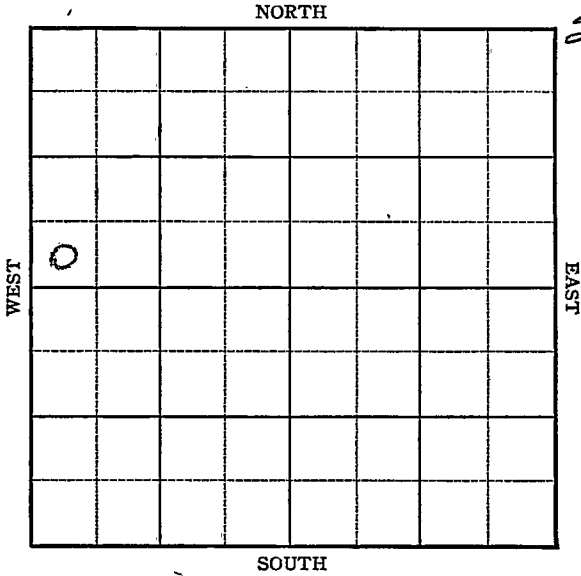

KANSAS

Barton County ✓

Sec. 4 Twp. 17 R. 11W

Well No. #6 Grosshardt Farm

Black-Marshall Company

Kraft-Prusa


_____ Ft. from N. Line

330 _____ Ft. from S. Line

_____ Ft. from E. Line

330 _____ Ft. from W. Line

SW NW

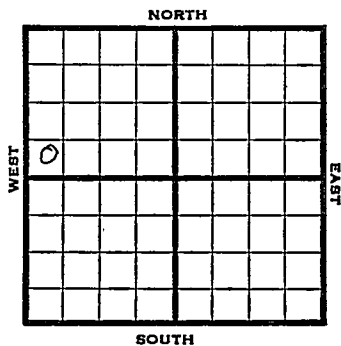

1946

Elev. 1866

REPORT

4/17 Location .

4/23 8" @ 236
Anhy 720
Drlg 2325

5/1 Lans 3029
Arb 3291

TD 3293-5" @ 3292 RUST

5/7 " " "

5/15 Arb. 3291
5" @ 3292
TD 3294'
Pump 383 Pot.
Grav. 42.0

COMPLETED

KANSAS Kansas Pool Name Kraft-Prusa

Map No. 55 Sec. 4 Twp. 17 R. 11W

Well No. 6 Grosshardt

Black-Marshall Company

FIRST REPORT Contractor

SW NW

SECTION PLAT

_____ Ft. from N. Line

330 Ft. from S. Line

_____ Ft. from E. Line

330 Ft. from W. Line

o			

Barton County

Location X

Rig up _____

Drilling and Remarks:

RECORD

Cased _____ in., _____ ft.

Sand _____

Gas _____

Oil _____

Total Depth _____

PRODUCTION

1st 24 hrs. Nat. _____

1st 24 hrs. after shot _____

Gas _____ Cu. Ft.

Dry Hole _____

Abandoned _____

Date

APR 17 1946 19

S. J. LEWIS Scout

